


T. 11S. R. 1W. W.M.

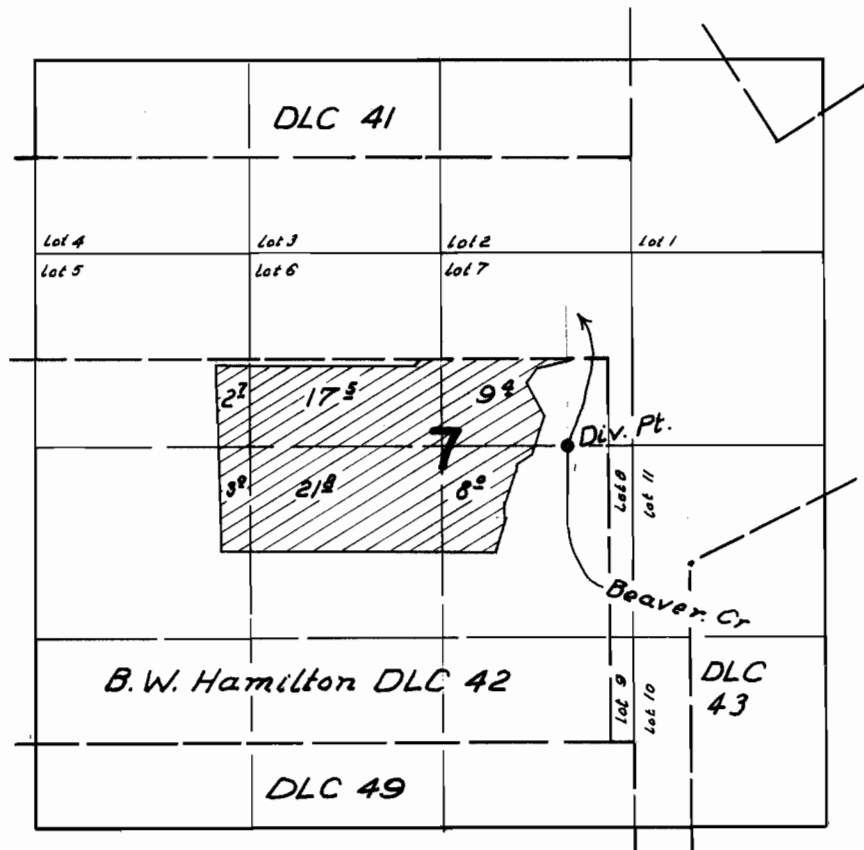

FINAL PROOF SURVEY

UNDER

Application No. 29199 Permit No. 22949

IN NAME OF

R.C. Draper

Surveyed Sept. 1, 1959, by R.H. Jackson