


T.3S.R.38E.W.M.

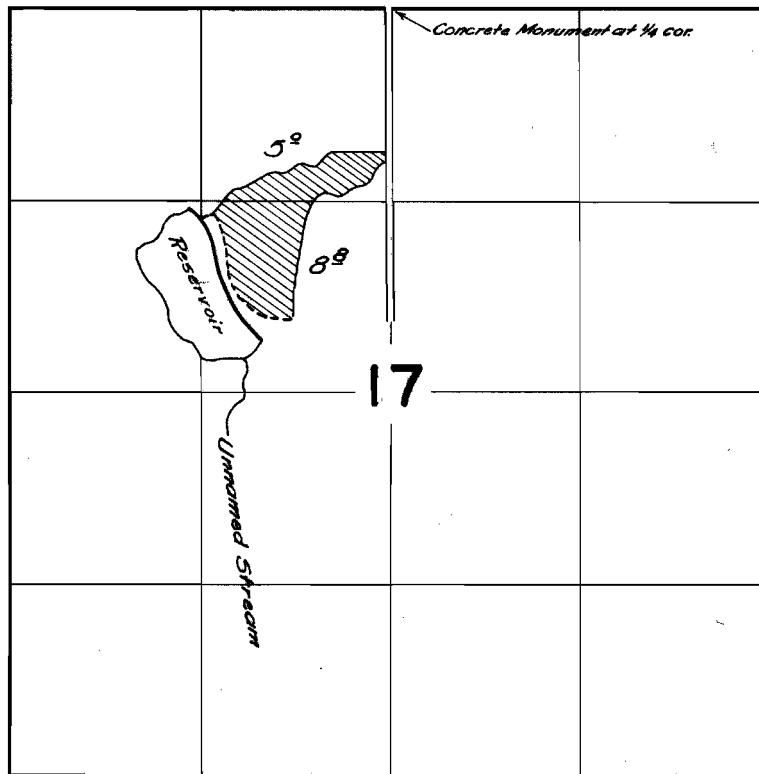

FINAL PROOF SURVEY
UNDER

Application No. *R-29057* 29058... Permit No. *R-1630* 22973...
IN NAME OF

.....*G. W. Spence*.....

Surveyed *Aug. 4* 1959, by *C. D. Bartels*