


T.18S.R6W.W.M.

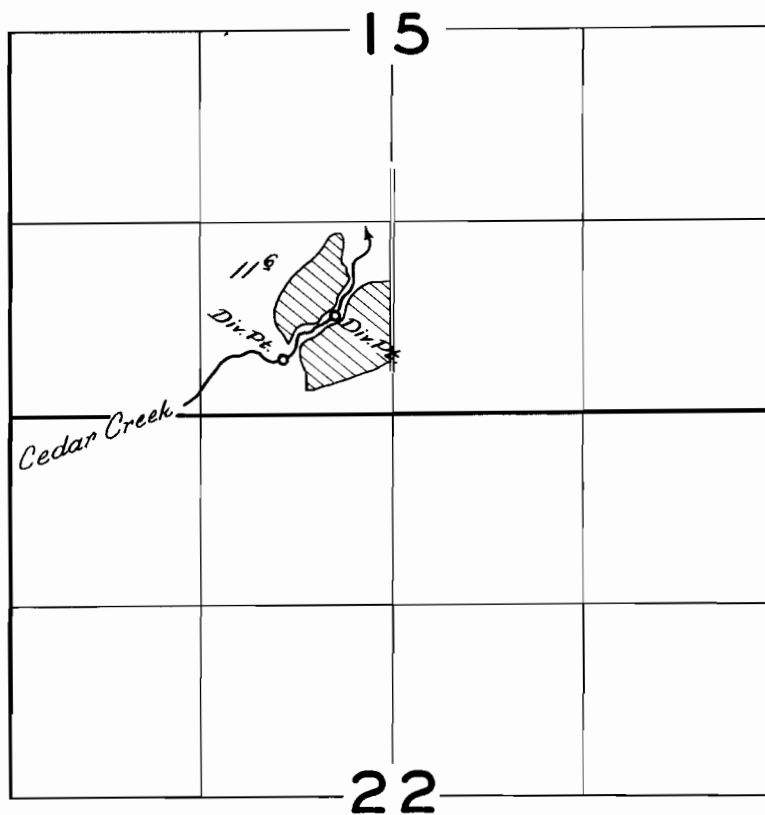

**FINAL PROOF SURVEY**  
UNDER

Application No. 29739 Permit No. 23254  
IN NAME OF

*Gordon H. & Neil K. Torrey*

Surveyed May 10 '959, by *R.H. Whitby*