


T.26S.R.12W.W.M.

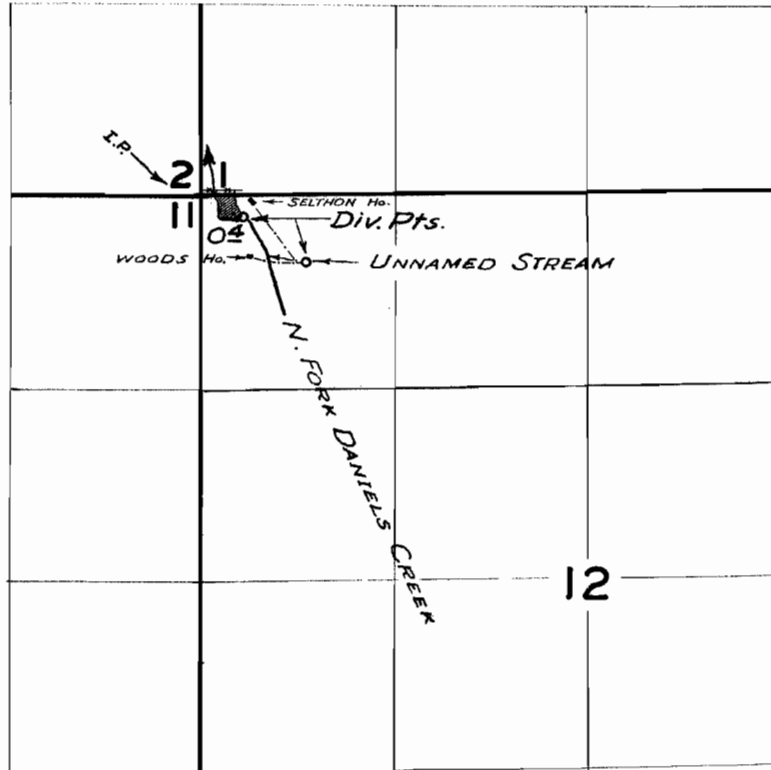

FINAL PROOF SURVEY UNDER

Application No. 29580 Permit No. 23296
IN NAME OF

BERNHARD N. & EDNA LOUISE SELTHON

Surveyed 17 July 1958, by M. Bish