


T. 7S. R. 3W. W.M.

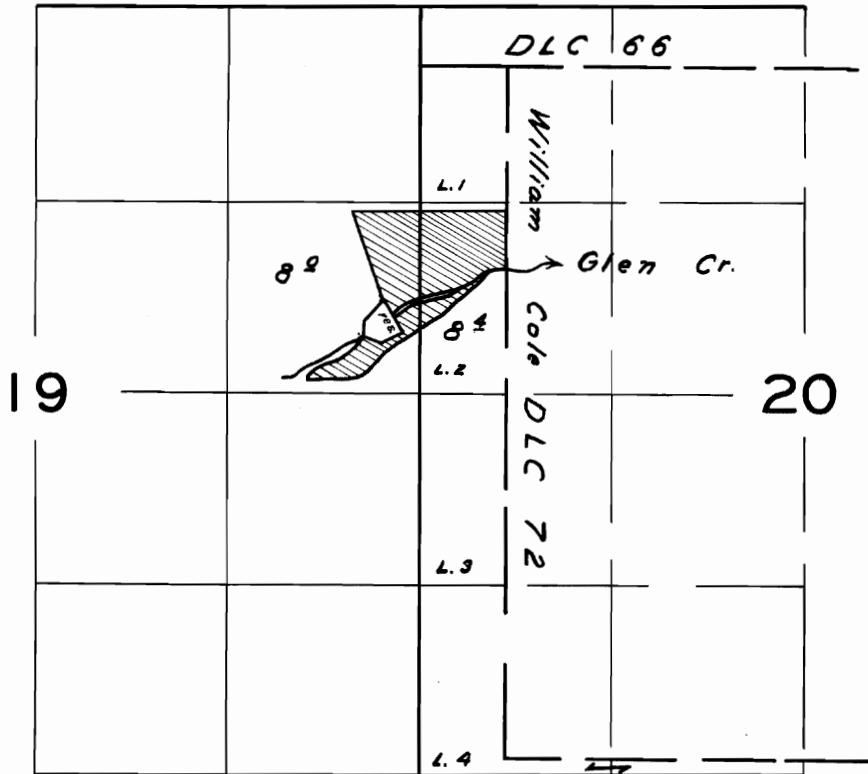

**FINAL PROOF SURVEY**  
UNDER

R-29606 R-1698  
Application No. 29607 Permit No. 23310  
IN NAME OF

*T. L. Shipler*

Surveyed July 28 1958, by *W. N. Perry*