


T. 7S. R. 1W. W.M.

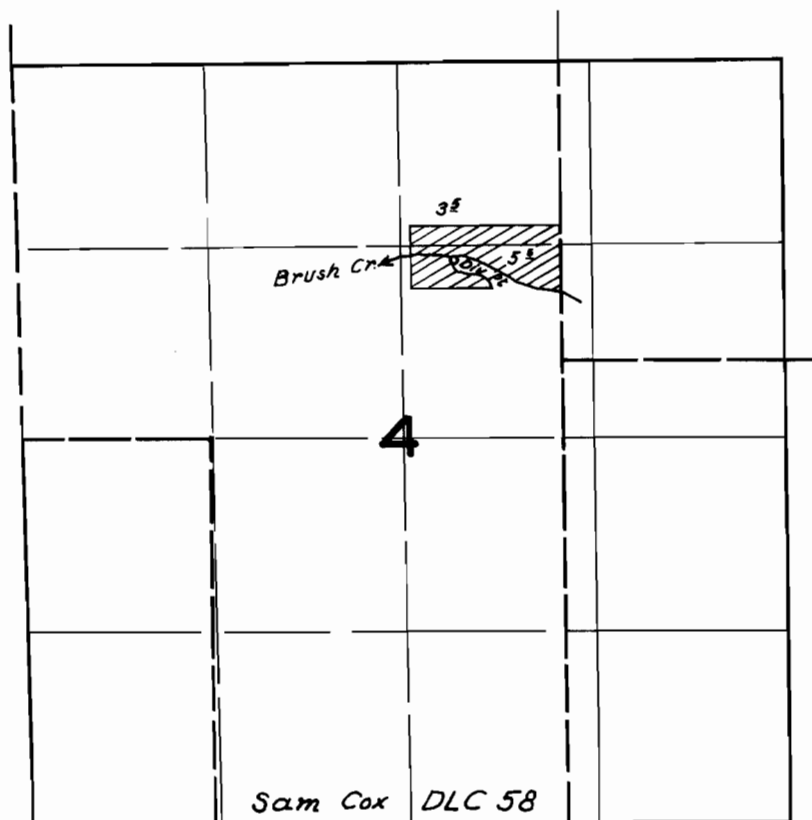

FINAL PROOF SURVEY UNDER

Application No. *30148* Permit No. *23563*
IN NAME OF

Arthur M. Hadley

Surveyed *June 10* 1959, by *R. H. Jackson*