


T.23S.R.5W.W.M.

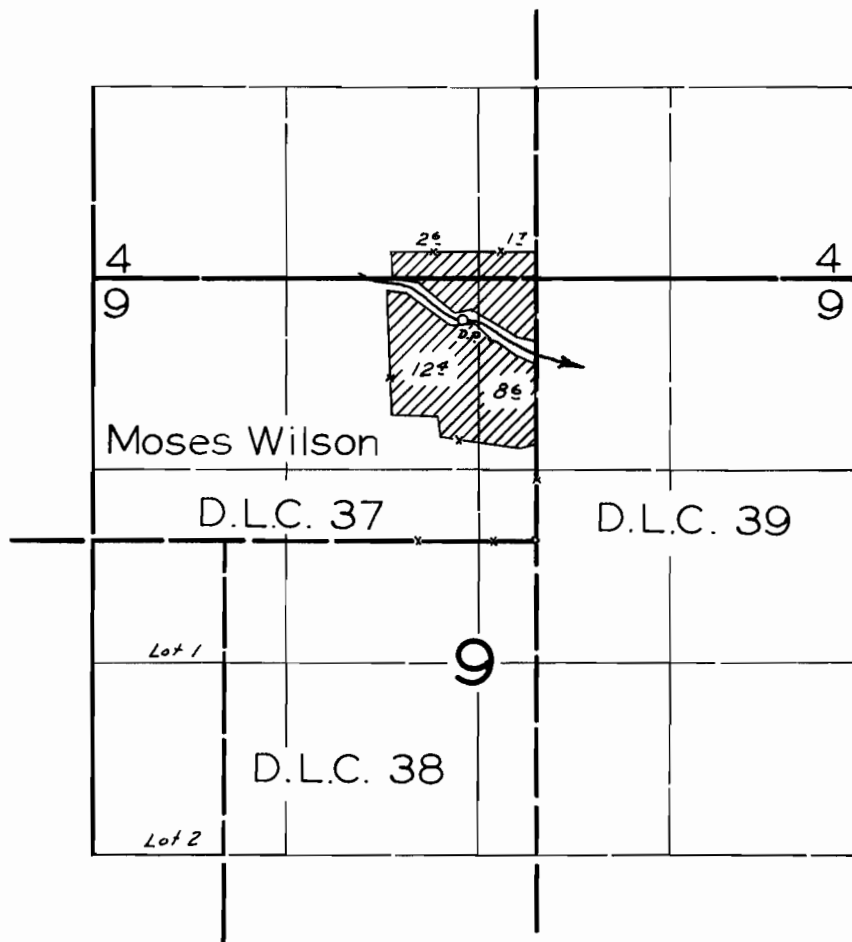

FINAL PROOF SURVEY
UNDER

Application No. 29653. Permit No. 23352.
IN NAME OF

WM. E. McDaniel

Surveyed June 19, 1959, by R. Jackson