


T. 1 S. R. 43 E. W.M.

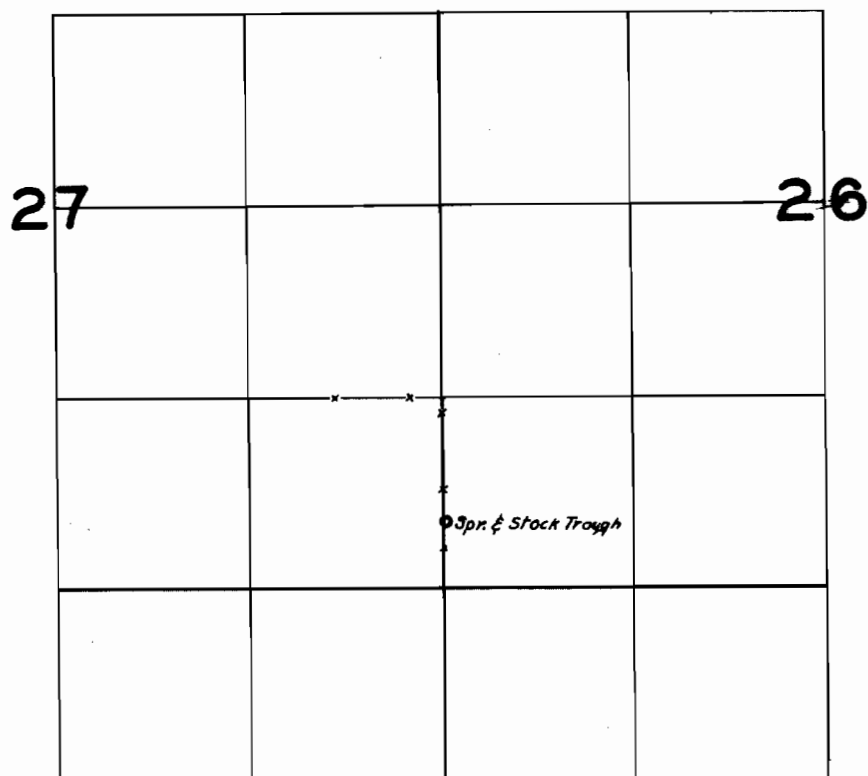

FINAL PROOF SURVEY
UNDER

Application No. 29990 Permit No. 23614
IN NAME OF

Isel Knodell Hug

Surveyed Aug. 13, 1959, by R.H. Jackson