


# T. 1 S. R. 3 W.W.M.

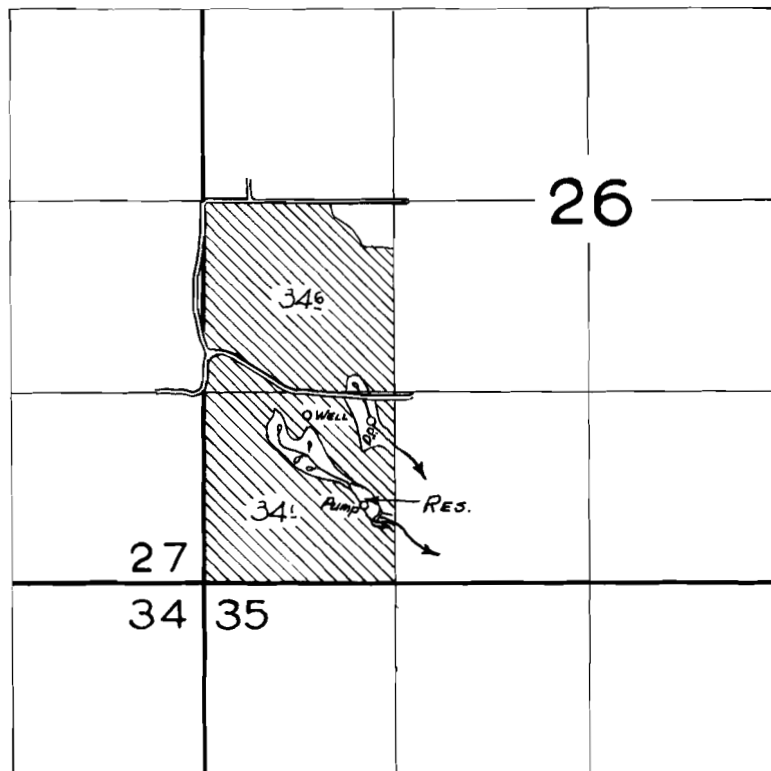

## FINAL PROOF SURVEY UNDER

R-29993                      R-1751  
29994                        23625  
Application No. G-430    Permit No. G-293  
IN NAME OF

WILLIAM F. & MARJORIE E. UNGER

Surveyed 27 May 1959, by *R. Jackson*