


T. 1 S. R. 3 W.W.M.

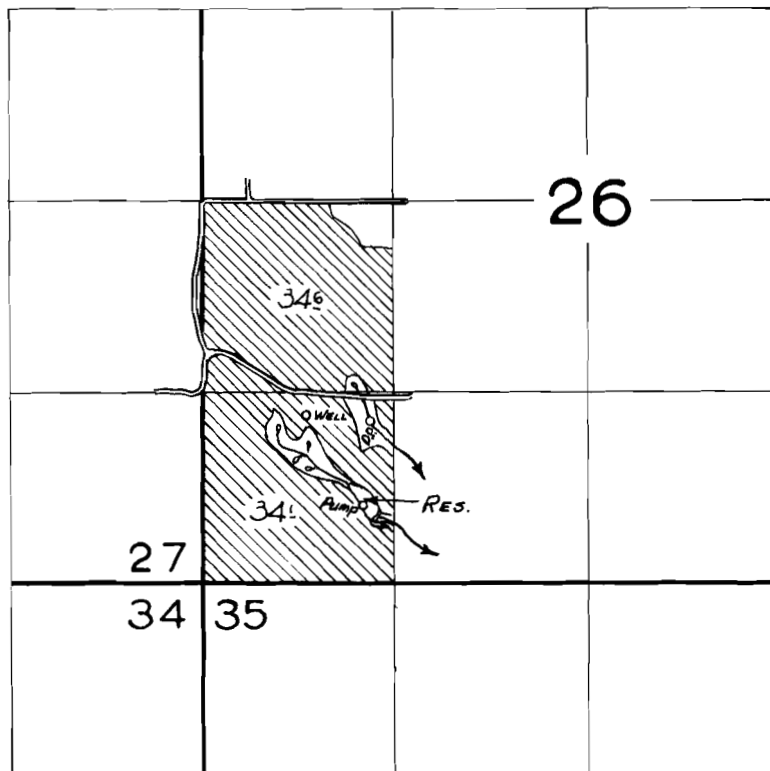

FINAL PROOF SURVEY UNDER

R-29993 R-1751
29994 23625
Application No. G-430 Permit No. G-293
IN NAME OF

WILLIAM F. & MARJORIE E. UNGER

Surveyed 27 May 1959, by *R. Jackson*