


T. 22S. R. 5 W. W.M.

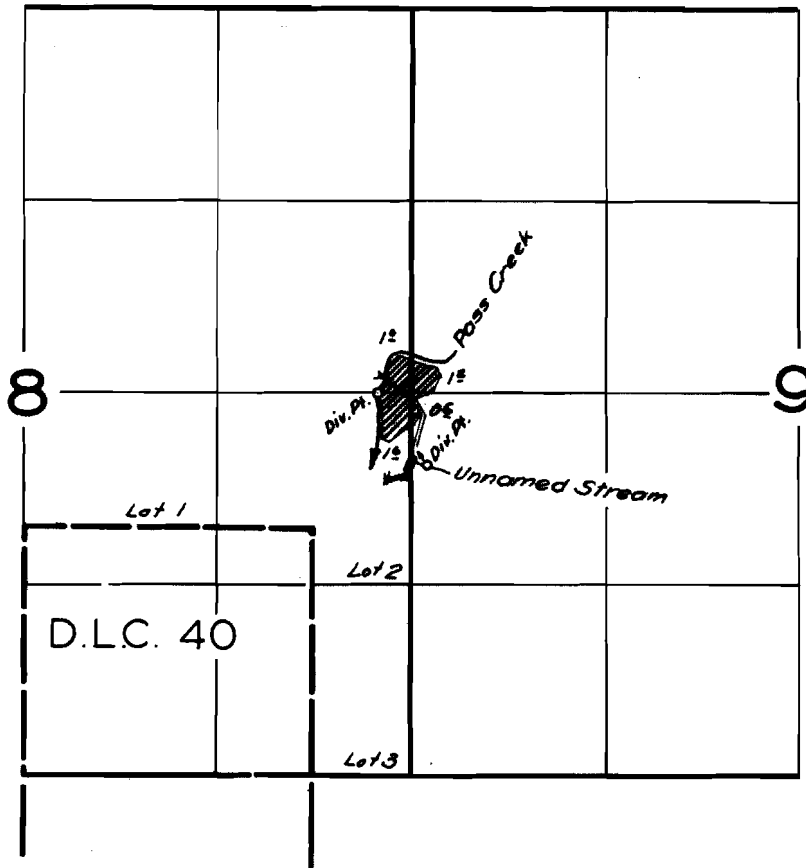

FINAL PROOF SURVEY
UNDER

Application No. ³⁰²⁷⁴ ~~30275~~ Permit No. ²³⁷²³ ~~23724~~
IN NAME OF

MANLEY A. & ADELINE B. WATSON

Surveyed June 17, 1959, by R. Jackson