


T. 22S. R. 5 W. W.M.

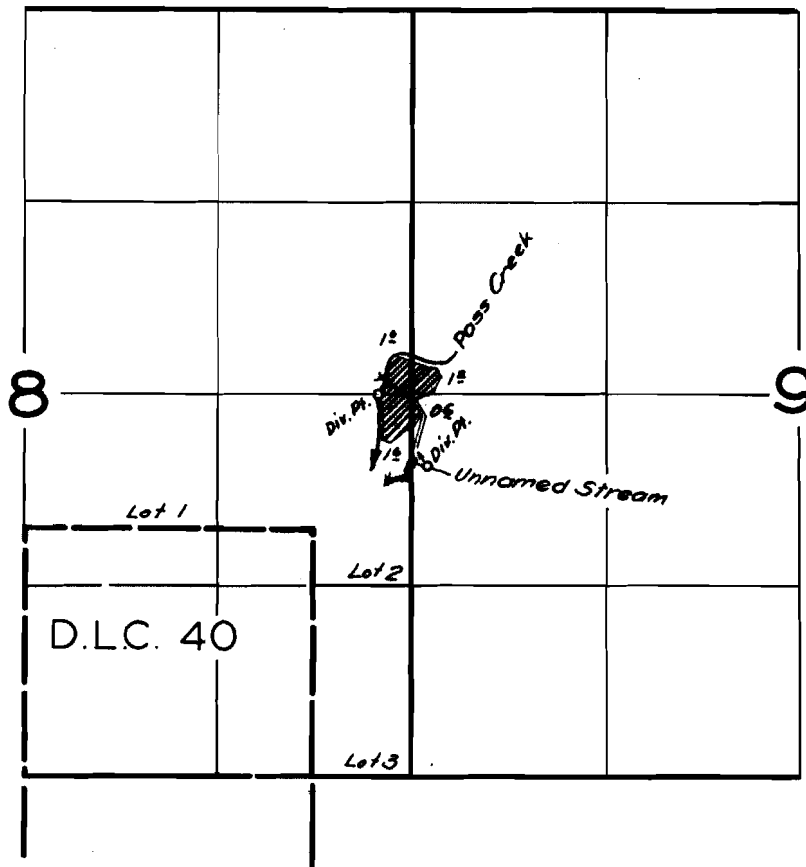

**FINAL PROOF SURVEY**  
UNDER

Application No. <sup>30274</sup> ~~30275~~ Permit No. <sup>23723</sup> ~~23724~~  
IN NAME OF

MANLEY A. & ADELIN B. WATSON

Surveyed June 17, 1959, by R. Jackson