


# T. 1 S. R. 39 E. W.M.

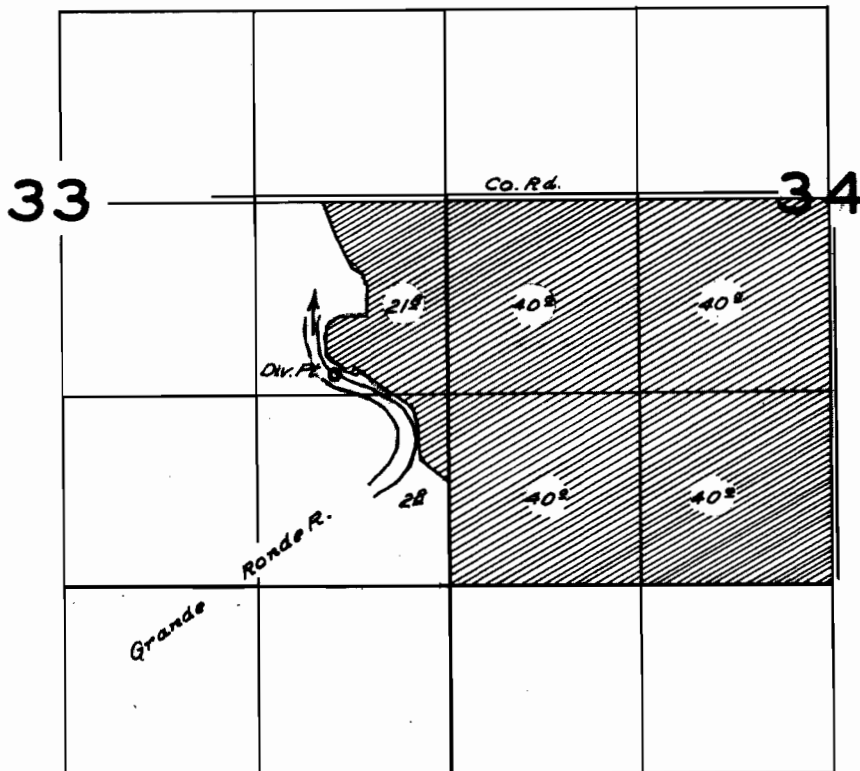

## FINAL PROOF SURVEY UNDER

Application No. 30114 Permit No. 23769  
IN NAME OF

Marcel Tromp van Holst

Surveyed Aug. 15 1959, by R.H. Jackson