


T. 3N. R. 10W. W.M.

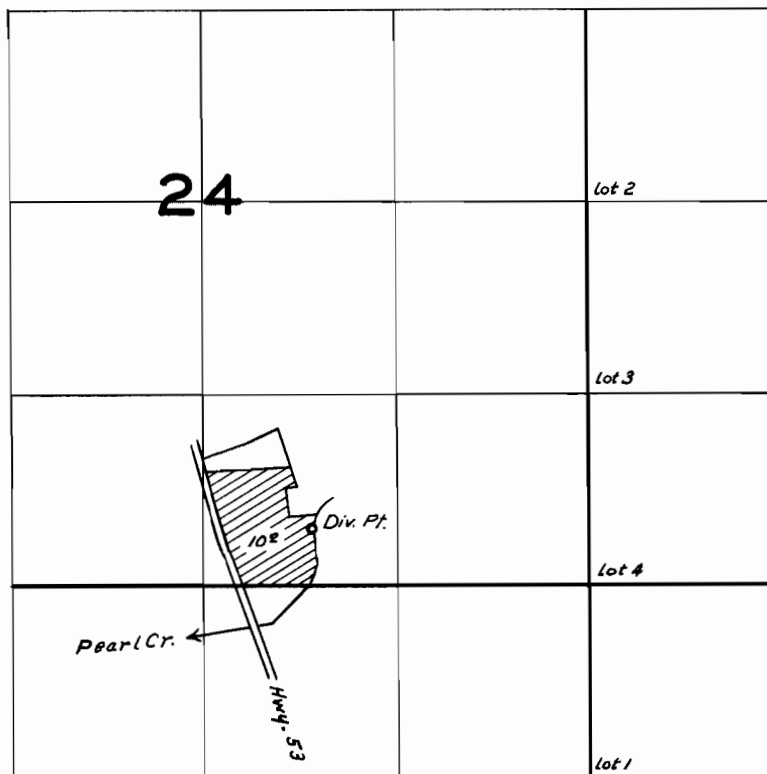

FINAL PROOF SURVEY
UNDER

Application No. 30159 Permit No. 23793.
IN NAME OF

..... *Lester C. Walker*

Surveyed *April 15* 1959, by *R.H. Jackson*