


T. 40S. R. 19E. W.M.

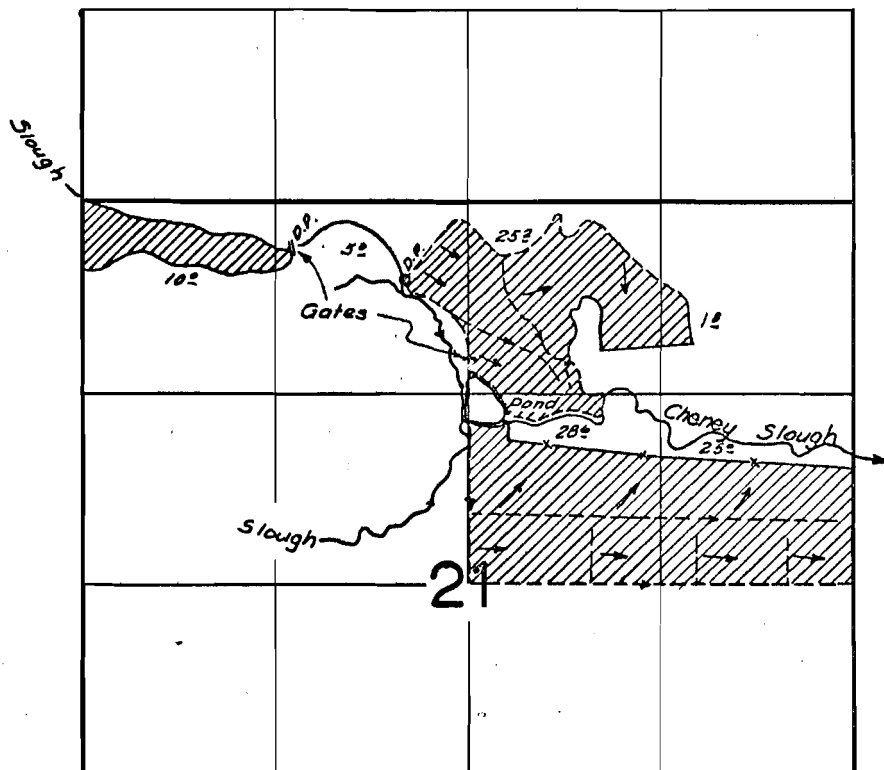

FINAL PROOF SURVEY UNDER

Application No. 27931... Permit No. 23915...
IN NAME OF

MARGUERITE K. & ROBERT C. NELSON

Surveyed May 15, 1959, by *R. Jackson*

40-19 ✓

CHZ-56K-169