


T.22S.R.7W.W.M.

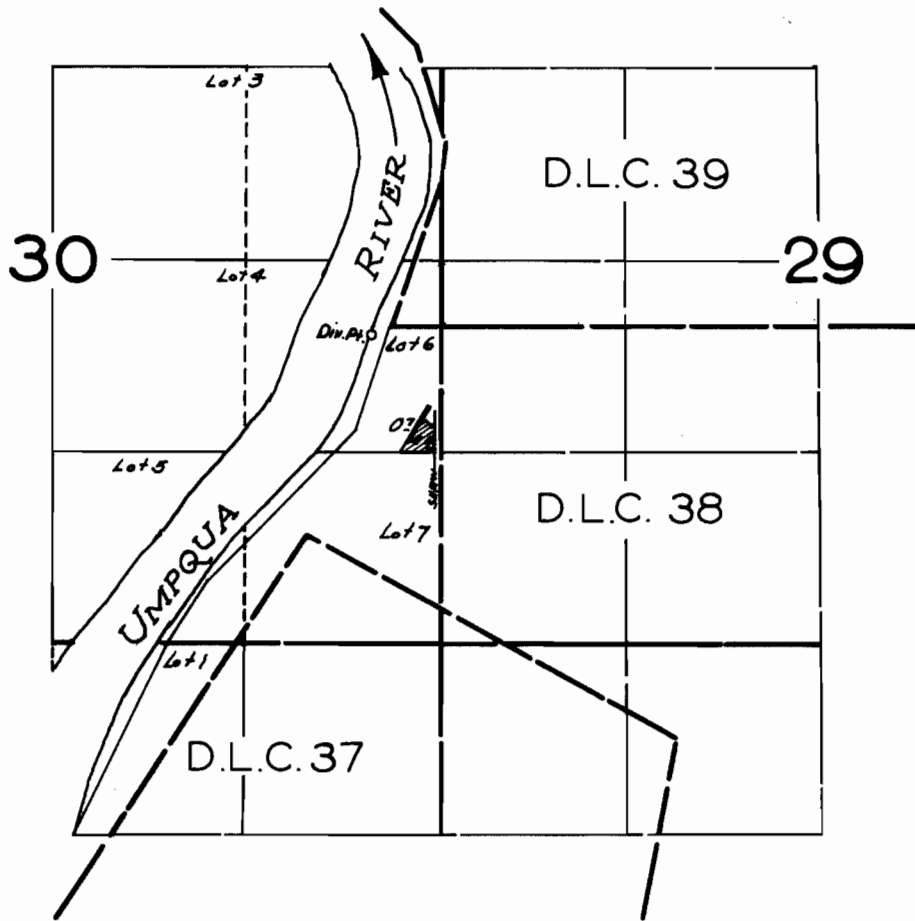

FINAL PROOF SURVEY
UNDER

Application No. 30505. Permit No. 24024
IN NAME OF

DONALD & IRMA JEAN MODE

Surveyed June 10, 1959, by *R Jackson*