


T. 34 S. R. 6 W. W. M.

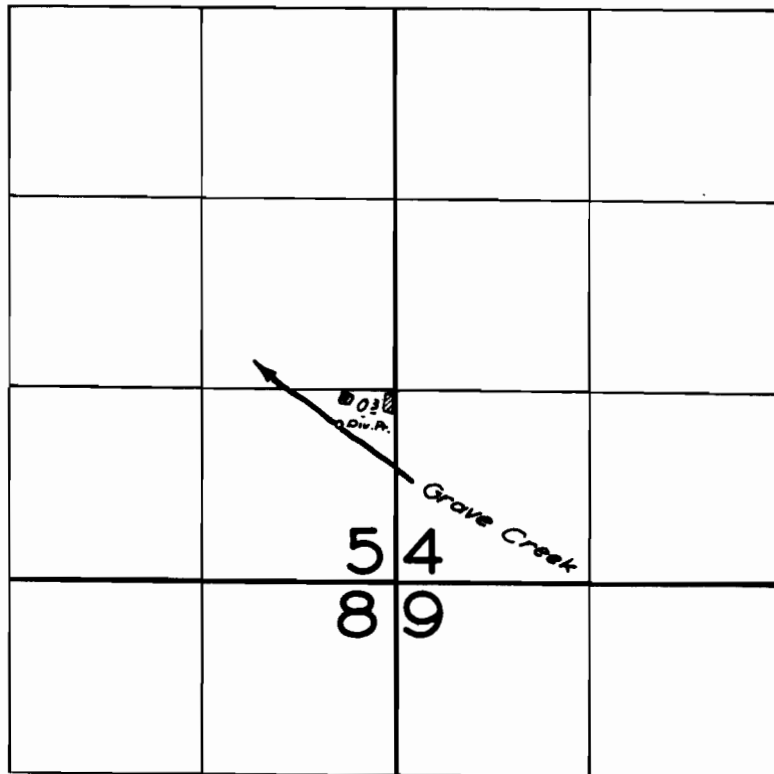

FINAL PROOF SURVEY
UNDER

Application No. 30543 . Permit No. 24048
IN NAME OF

ORIN C. BROKAW, JR.

Surveyed July 14, 1959, by *R. H. Jackson*