


T. 2^N. R. 3 W. W.M.

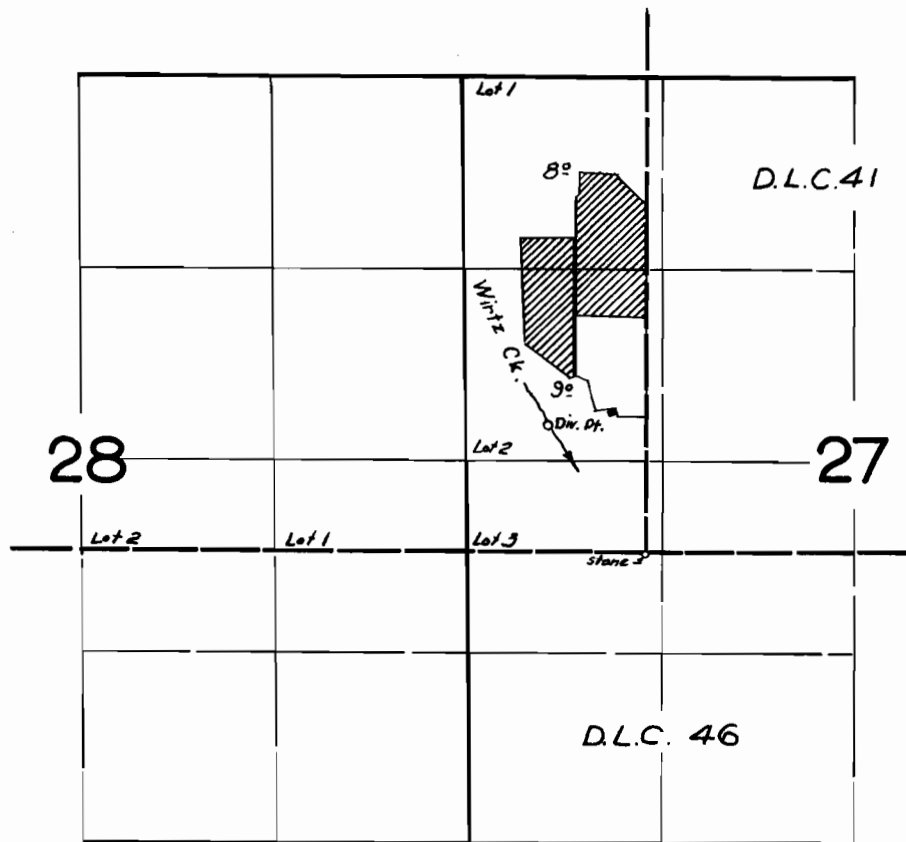

FINAL PROOF SURVEY
UNDER

Application No. 30564 Permit No. 24079
IN NAME OF

CLYDE F. BATEMAN

Surveyed 28 May. 1959, by *R.H. Jackson*