


24166
26954

T.39 SR JOE W.M.

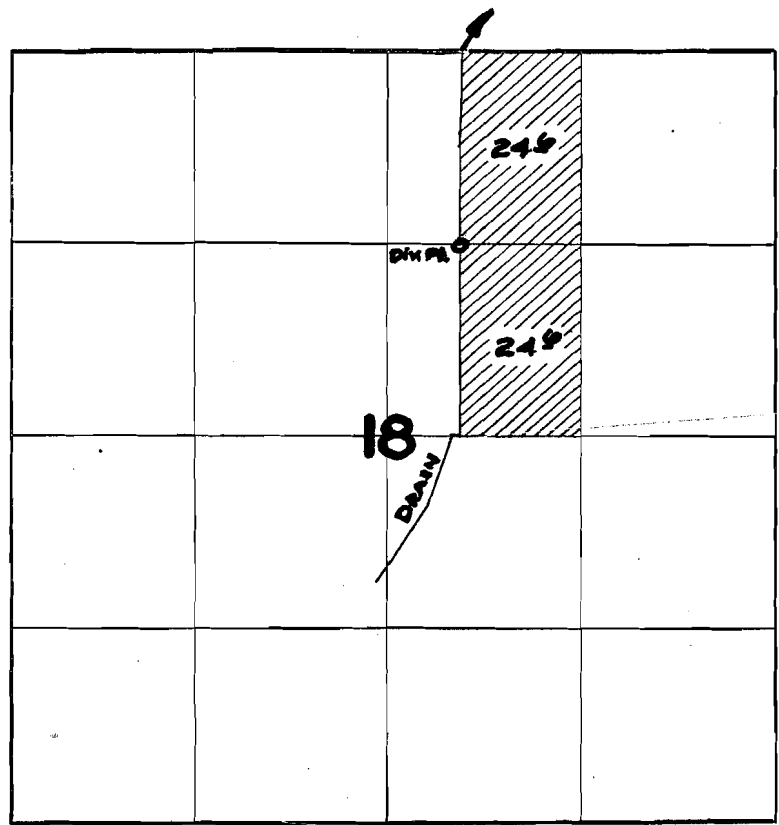

Just under misc.

FINAL PROOF SURVEY

UNDER

Application No. 30577... Permit No. 24166

IN NAME OF

GLEN L. HILYARD

Surveyed 24 Oct. 19 59, by M. B. Bish