


T.33 S. R. 6 W.W.M.

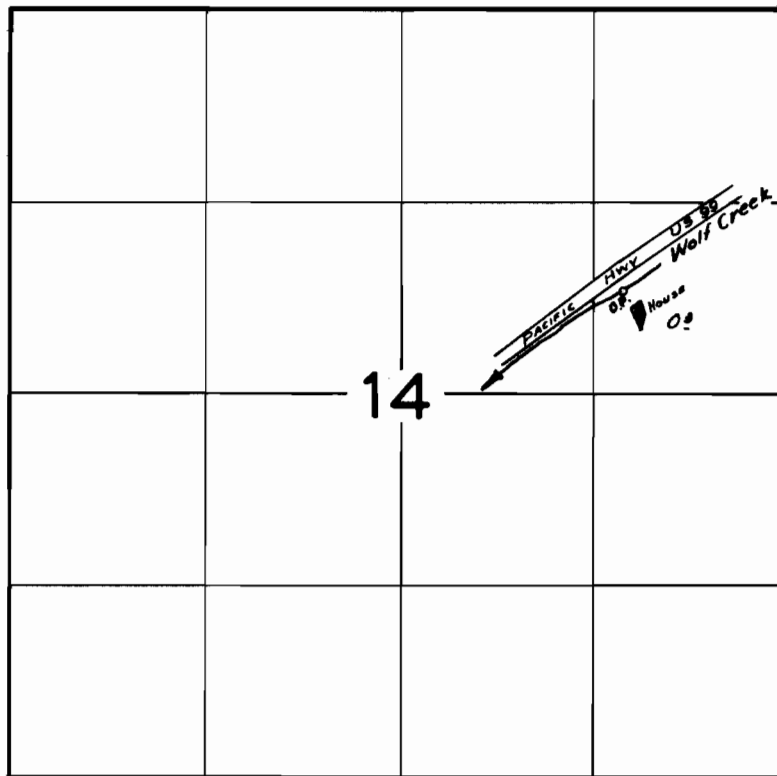

FINAL PROOF SURVEY
UNDER

Application No. 30699 Permit No. 24186
IN NAME OF

LENA GARRISON

Surveyed July 15, 1959, by *L. Jackson*