


T. 1S. R. 2W.W.M.

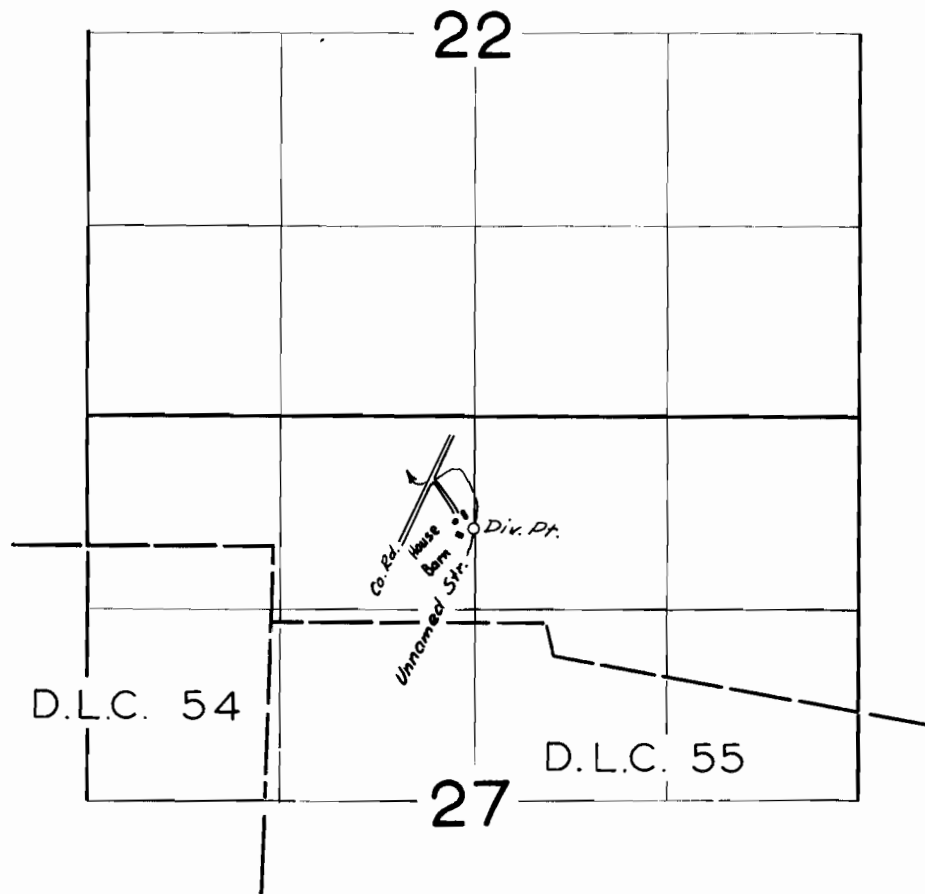

**FINAL PROOF SURVEY**  
UNDER

Application No. 30798 . Permit No. 24248  
IN NAME OF

ANTON SCHLESSER

Surveyed June 4 1959, by *R. Jackson*