


T. 1 S. R. 44 E. W.M.

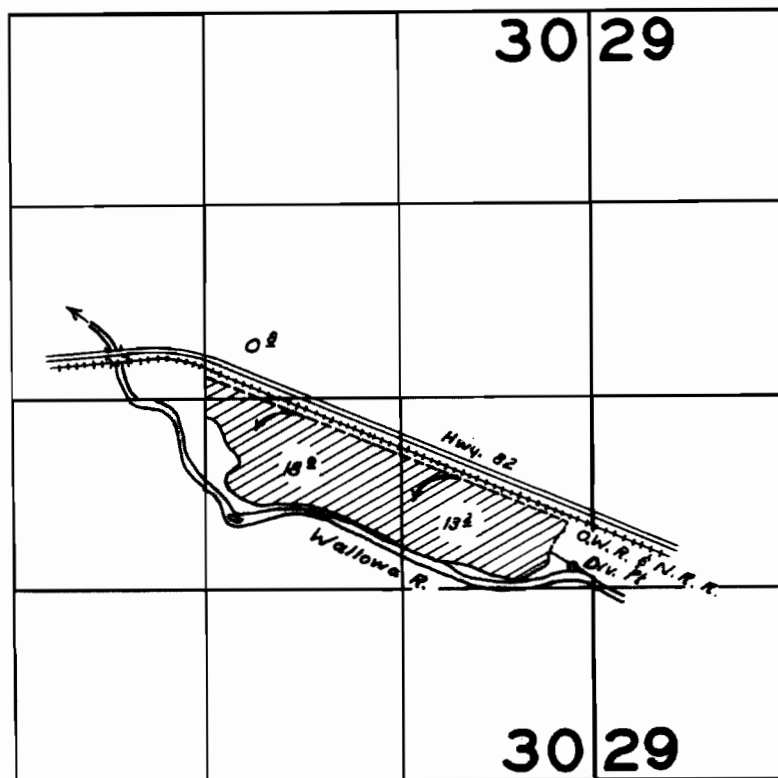

FINAL PROOF SURVEY UNDER

Application No. 30771 Permit No. 24291
IN NAME OF

W. R. Stein

Surveyed Aug. 13, 1959, by R.H. Jackson