


# T. 1 N. R. 2-3 W. W. M.

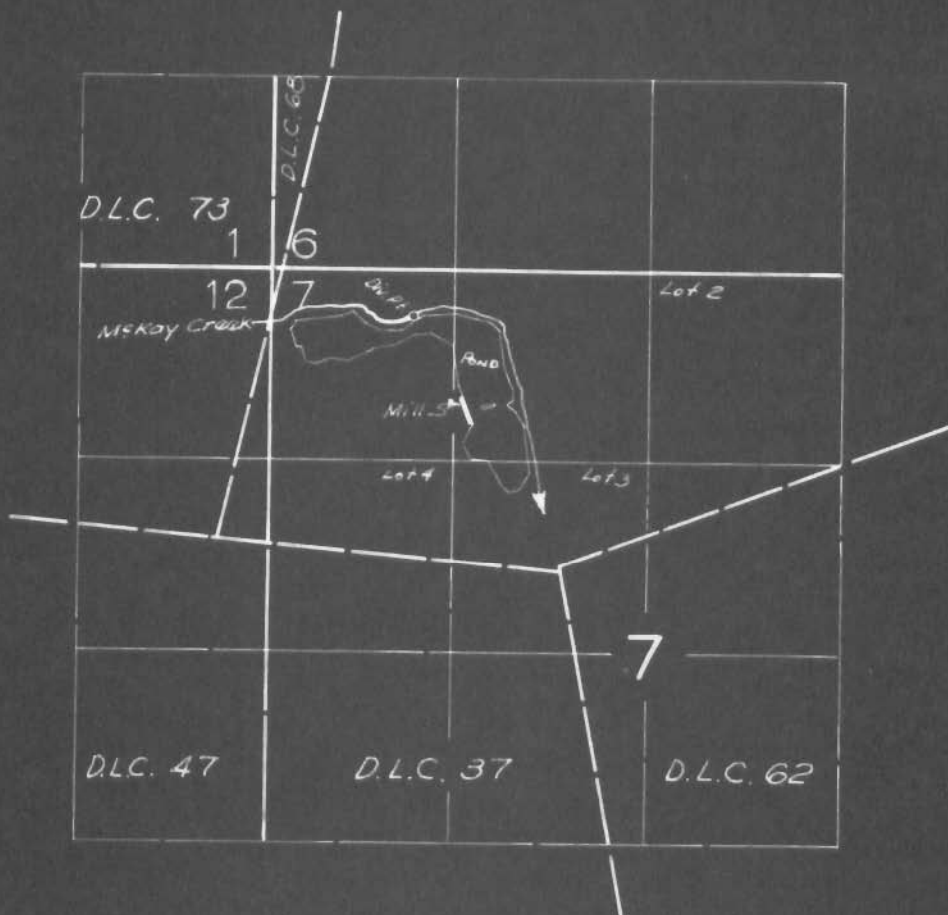

## FINAL PROOF SURVEY UNDER

R-29415      R-1917  
Application No. 30364      Permit No. 24434  
IN NAME OF

GLENN F. KOENNECKE

Surveyed 1 June 1959 by R. Haackon