


T. 1 S. R. 2 W. W. M.

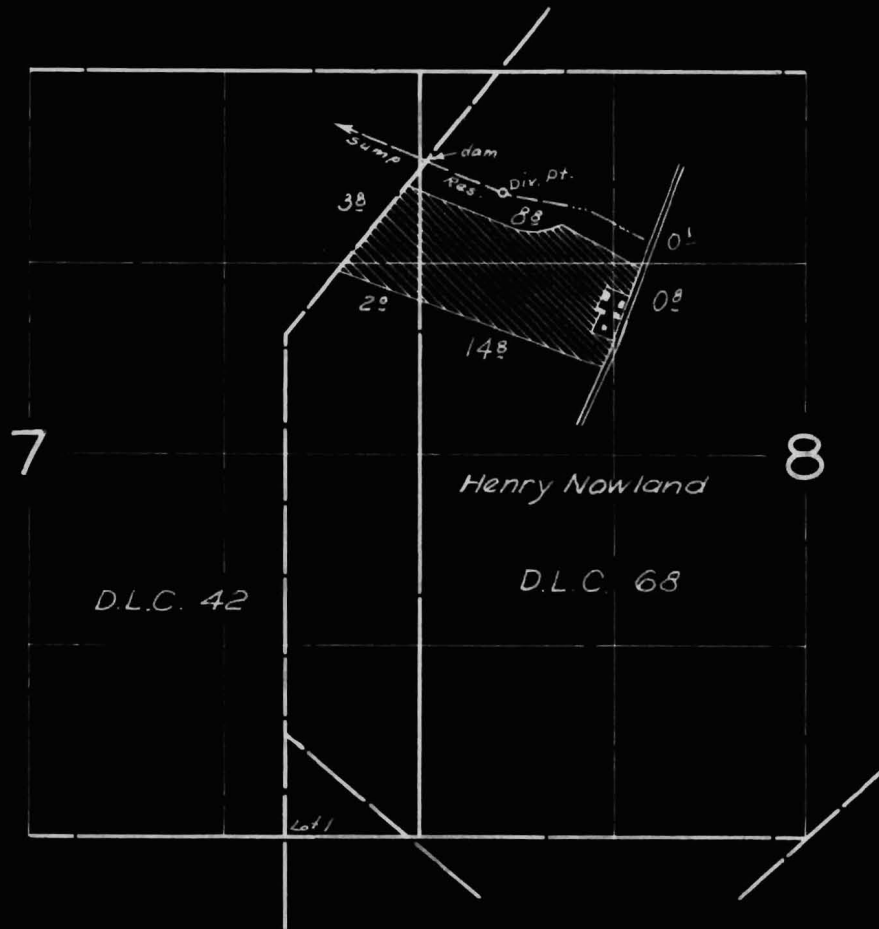

FINAL PROOF SURVEY
UNDER

R-30979 R-1938
Application No. 30980 Permit No. 24505
IN NAME OF

IWASAKI BROS. INC.

Surveyed 4 June 1959 by *R. Jackson*