


T. 1 S. R. 2 W. W. M.

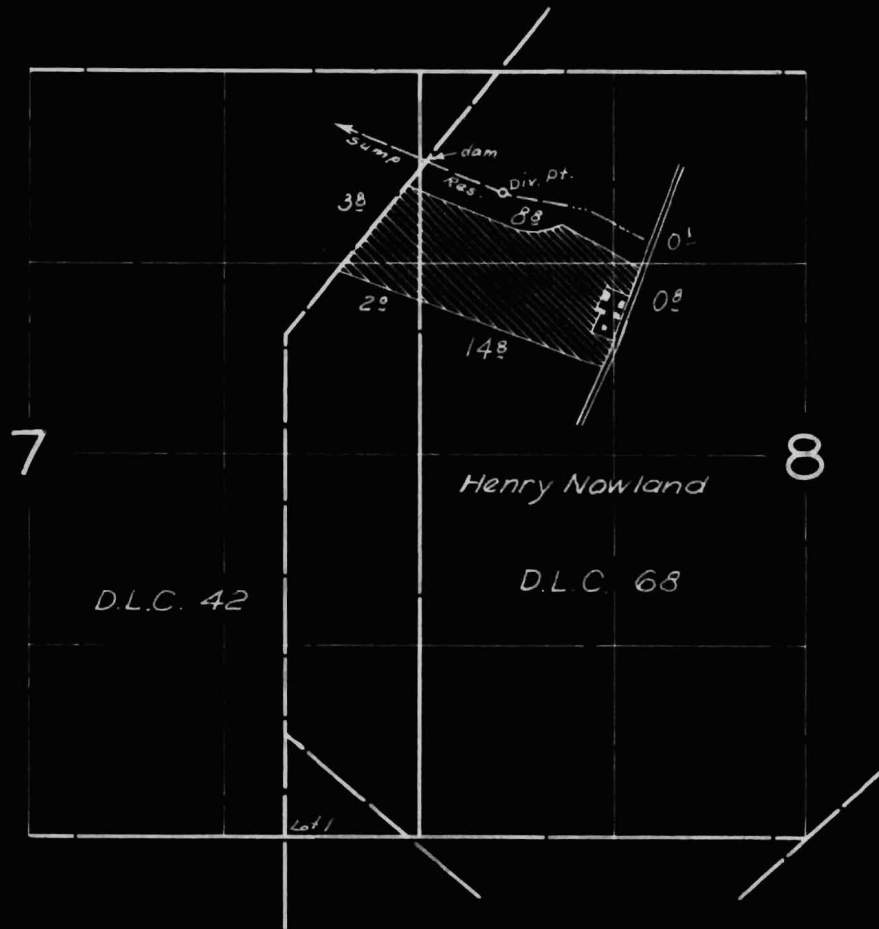

**FINAL PROOF SURVEY**  
UNDER

R-30979                      R-1938  
Application No. 30980      Permit No. 24505  
IN NAME OF

*IWASAKI BROS. INC.*

Surveyed 4 June 1959 by *R. Jackson*