


T. 26 S. R. 4 W. W. M.

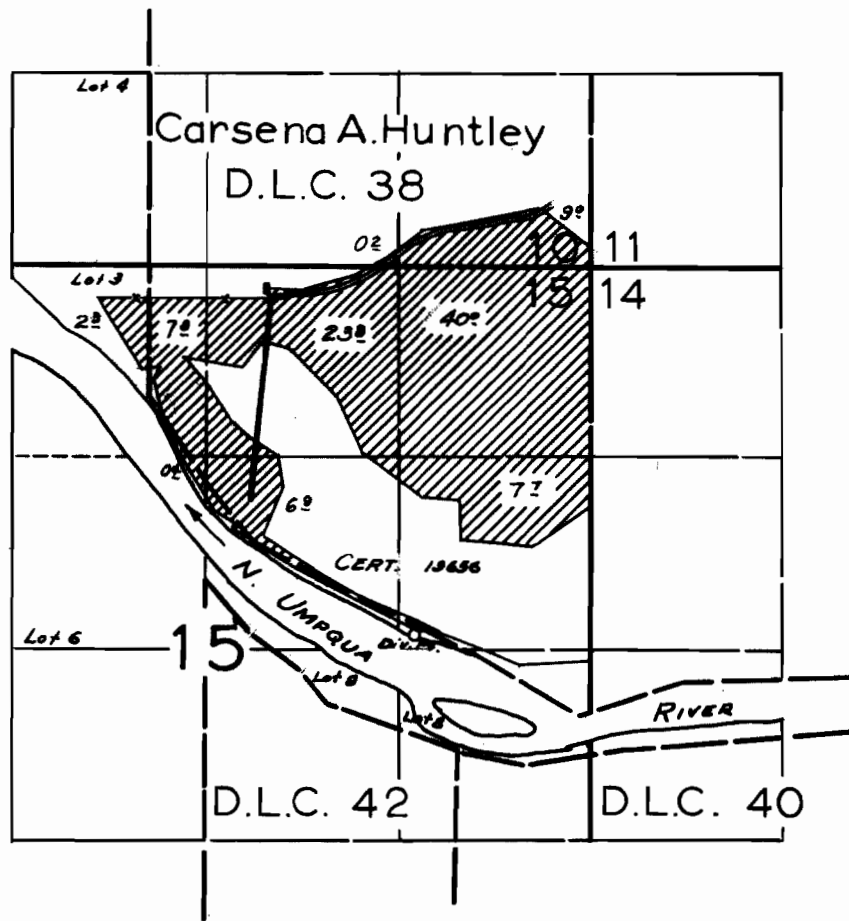

FINAL PROOF SURVEY
UNDER

Transfer 0-25
Application No. 31260 Permit No. 24629
IN NAME OF

R. B. OLIVER

Surveyed June 23 1959, by Al Jackson ✓