


T.25S. R. 7 W.W.M.

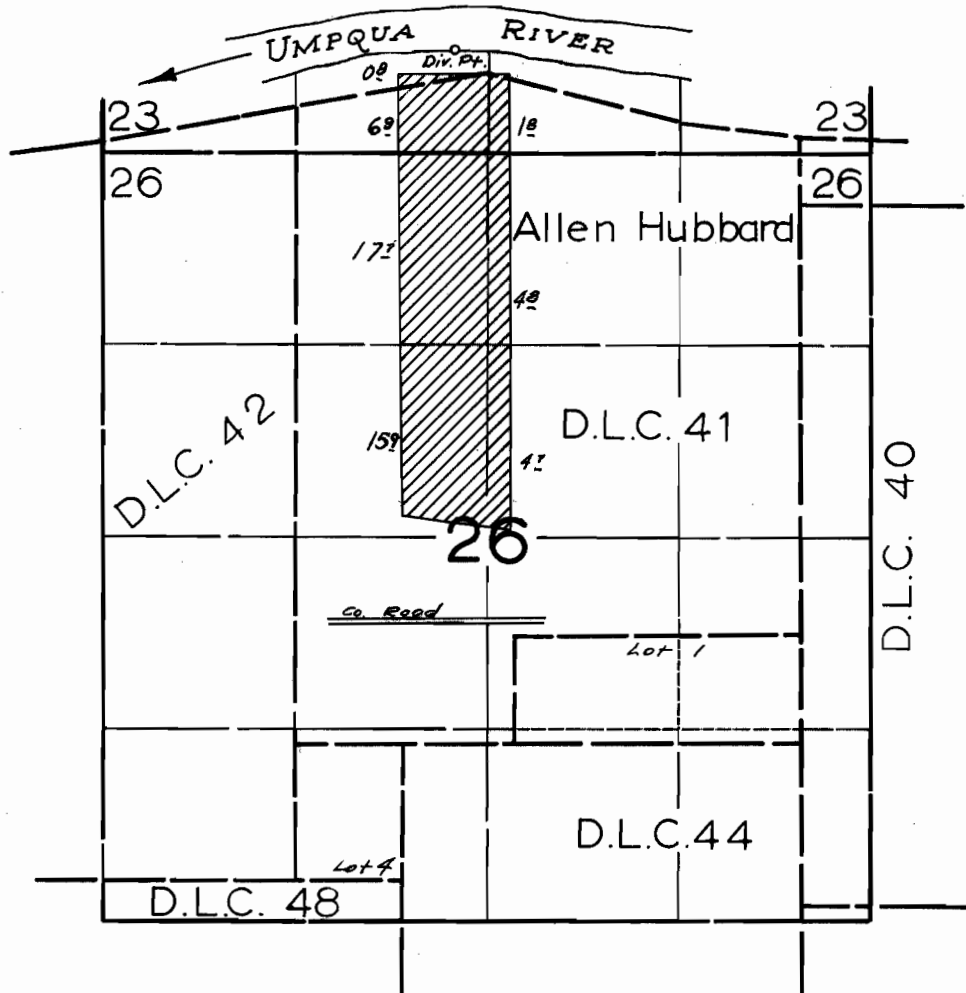

**FINAL PROOF SURVEY**  
UNDER

Application No. 3.14.26. Permit No. 2476.3  
IN NAME OF

HILBERT LEE

Surveyed June 22 1959, by *R. Jackson*