


30843

IT APPEARS THAT THIS LAND IS LOCATED TO FAR WEST. THE ~~WEST~~ COUNTY ROAD SHOULD BE ON THE "40" LINE ON EAST SIDE OF THE SW 1/4 SW 1/4 Section 31.

R. 5 W. W. M.

2-26-80
LMT

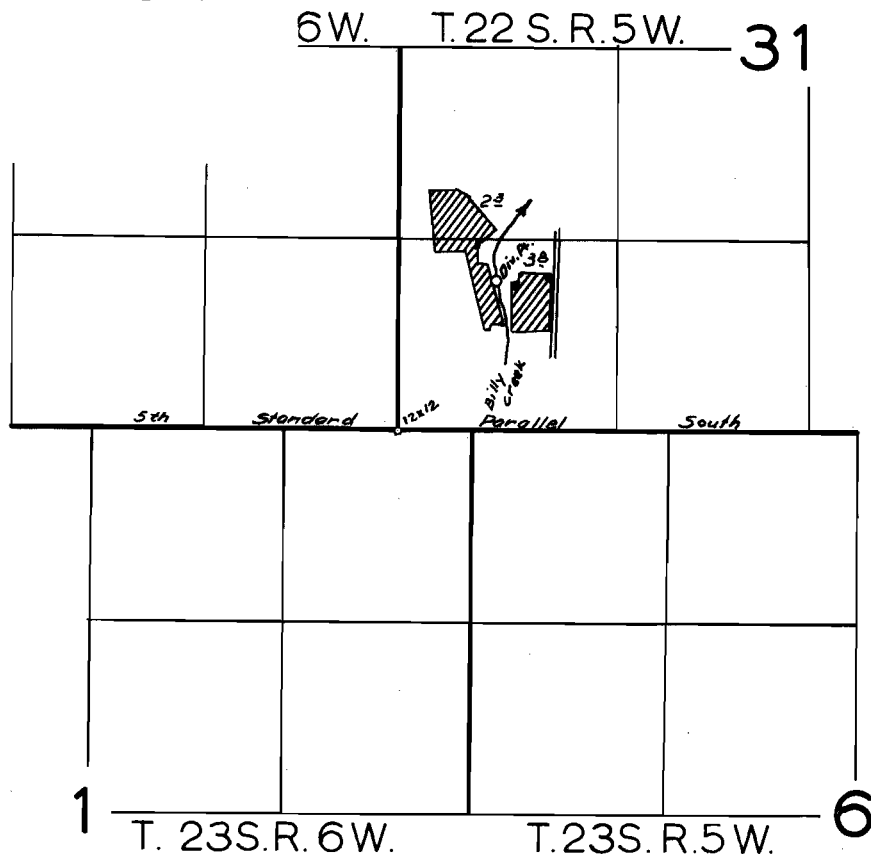

FINAL PROOF SURVEY
UNDER

Application No. 30843. Permit No. 24274.
IN NAME OF

JAMES DALTON ALLEN

Surveyed June 18, 1959, by R. H. Jackson