


T.26 S. R. 4 W.W.M.

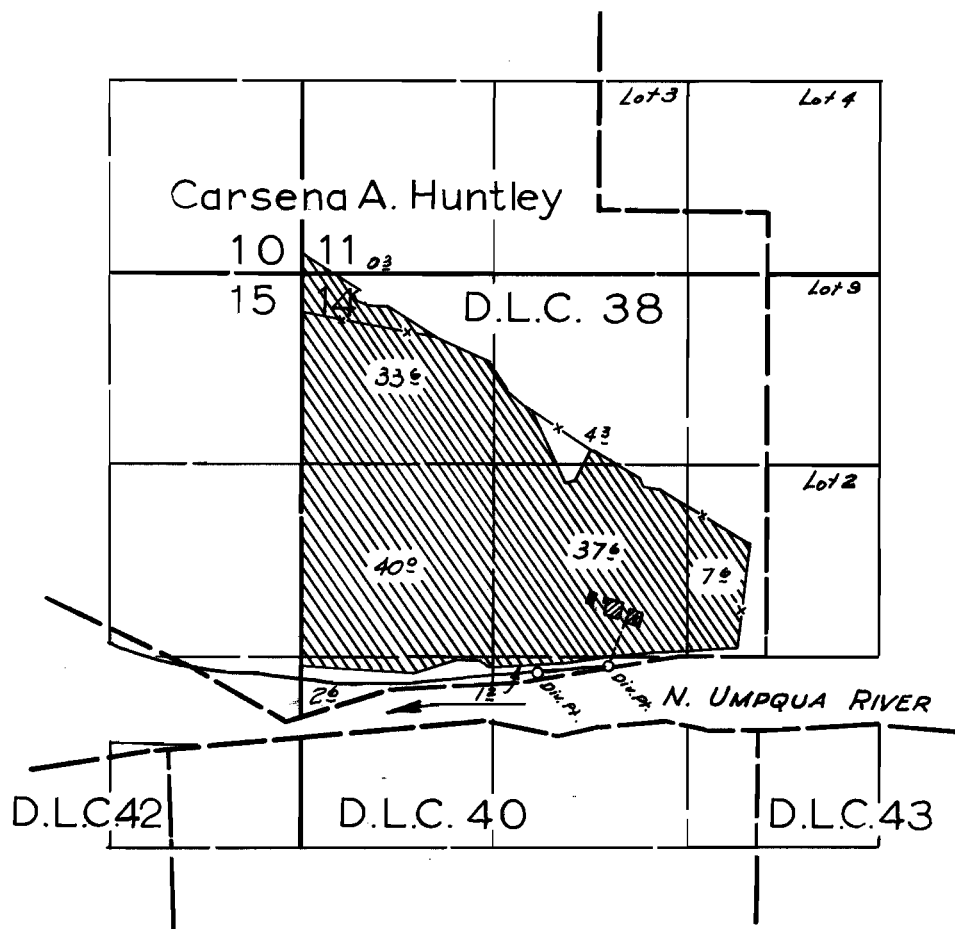

FINAL PROOF SURVEY UNDER

Application No. 30946.. Permit No. 2434.8
IN NAME OF

CARLISLE G. & MARJORIE S. GILBREATH

Surveyed June 23 1959, by *R. Jackson*