


T. 3 S. R. 45 E. W.M.

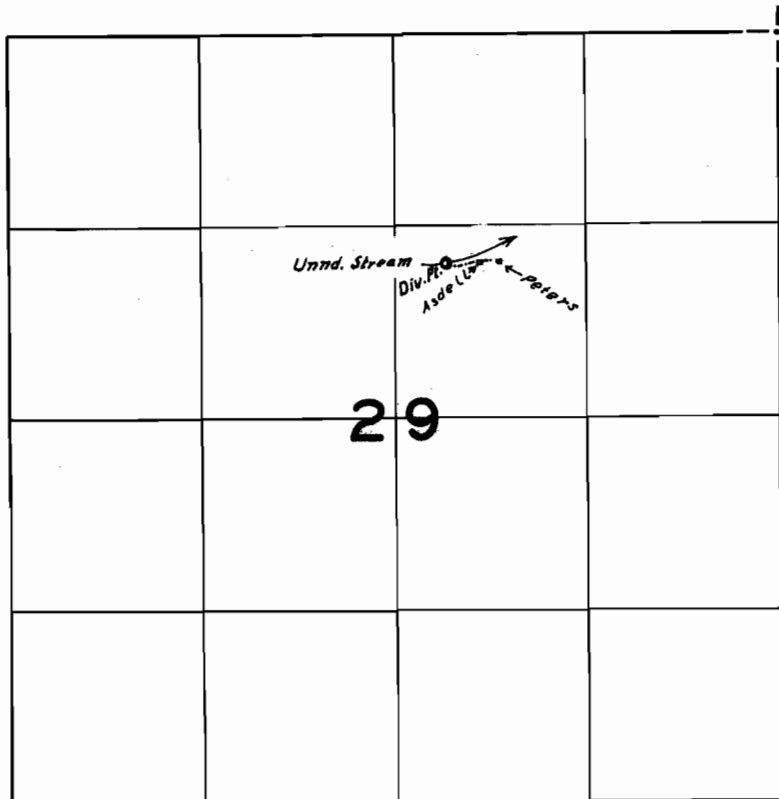

**FINAL PROOF SURVEY**  
UNDER

Application No. *30983* ..... Permit No. *24381* .....

IN NAME OF

*R.R. Asdell*

Surveyed *Aug. 11,* 1959, by *R.H. Jackson* .....