


T. 33S.R.6W.W.M.

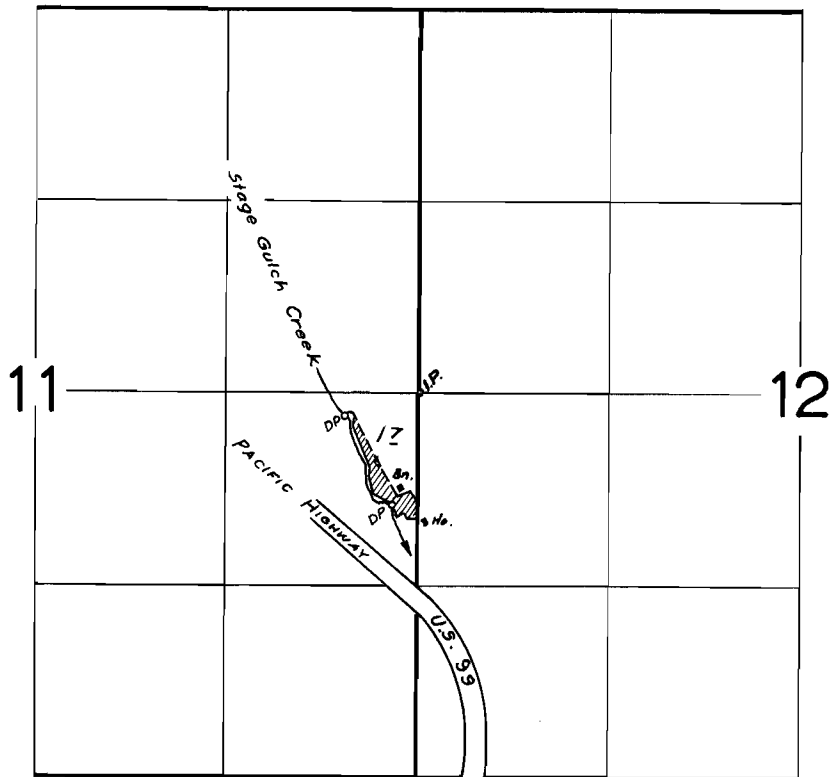

FINAL PROOF SURVEY
UNDER

Application No. 31458 Permit No. 24806
IN NAME OF

HERMAN S. STEWARD

Surveyed July 15, 1959, by R. Jackson