


T.41 S.R.42 E.W.M.

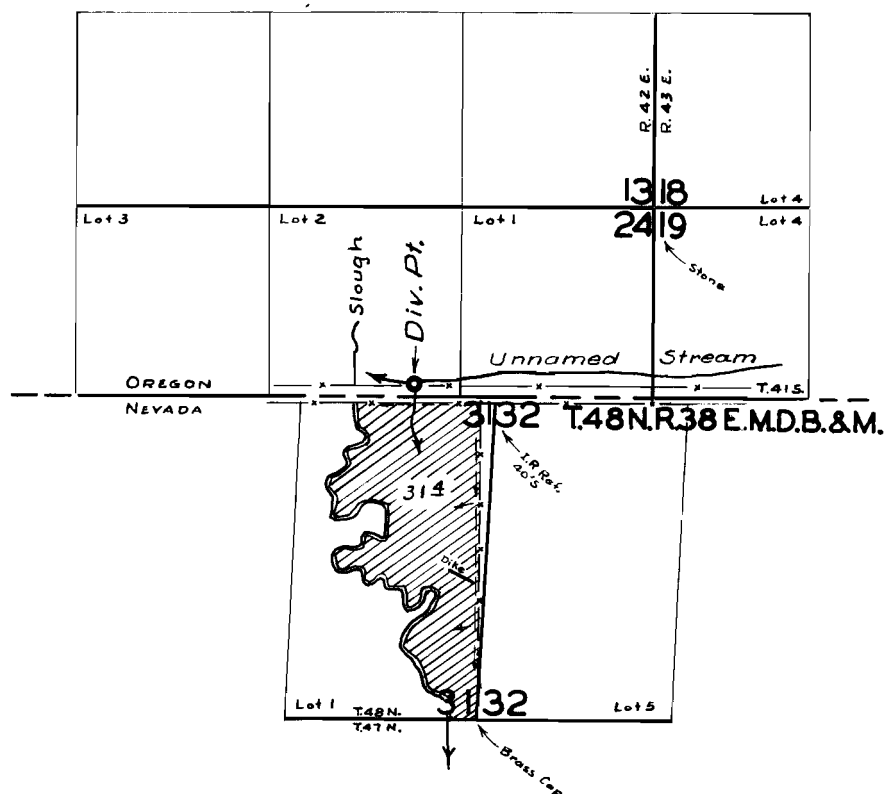

FINAL PROOF SURVEY
UNDER

Application No. 31731 Permit No. 25013
IN NAME OF

JOHN RUIZ

Surveyed 19 Sept. 1959, by M. B. Sch