


T. 17S. R. 3-4 W. W.M.

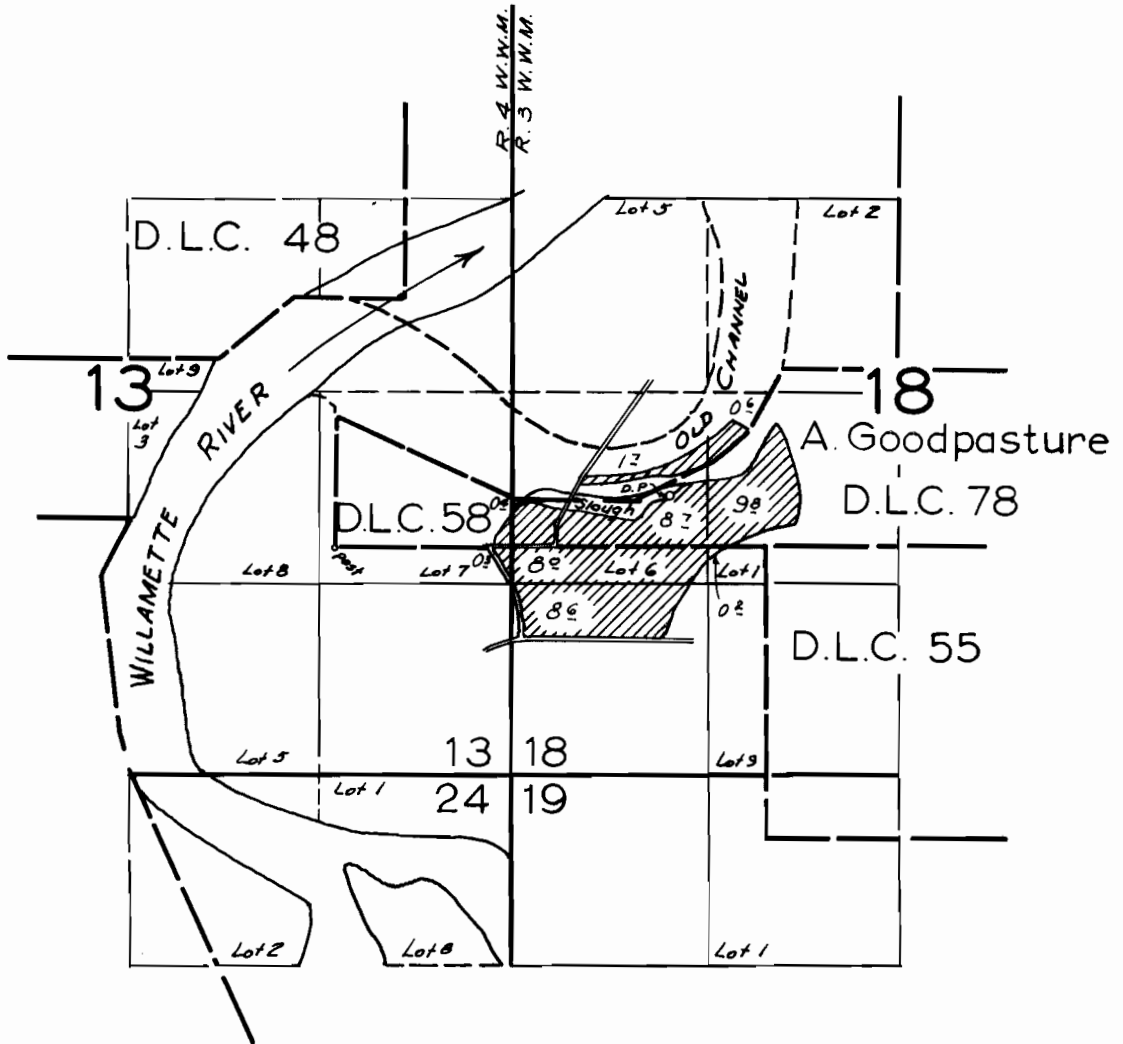

**FINAL PROOF SURVEY**  
UNDER

Application No. 32237 Permit No. 25433  
IN NAME OF

*FRANK R. KINGSLEY*

Surveyed April 1, 1959, by *R. Jackson*