

Map of survey showing Spring location in Section 5, and location of water application for domestic use in Section 6, all in Township 39 South, Range 2 East of the Willamette Meridian in Jackson County, Oregon.

SPRING LOCATION

Located in the NW $\frac{1}{4}$ of the NW $\frac{1}{4}$ of Section 5, T.39 S., R. 2 E., W.M., Jackson County, Oregon, at a point S.7 $^{\circ}$ 27' E. 1320.0 feet from the northwest corner of said Section.


LOCATION OF WATER APPLICATION POINT

Water to be applied in the Northeast Quarter of the Northeast Quarter of Section 6, Township 39 South, Range 2 East of the Willamette Meridian in Jackson County, Oregon.


Date: 7-19-58

Scale: 4" = 1 Mile

RECEIVED
MAY 19 1959
STATE ENGINEER
SALEM, OREGON

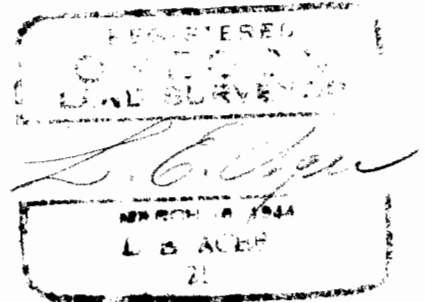

T. 39 S., R. 2 E. W.M. Oregon

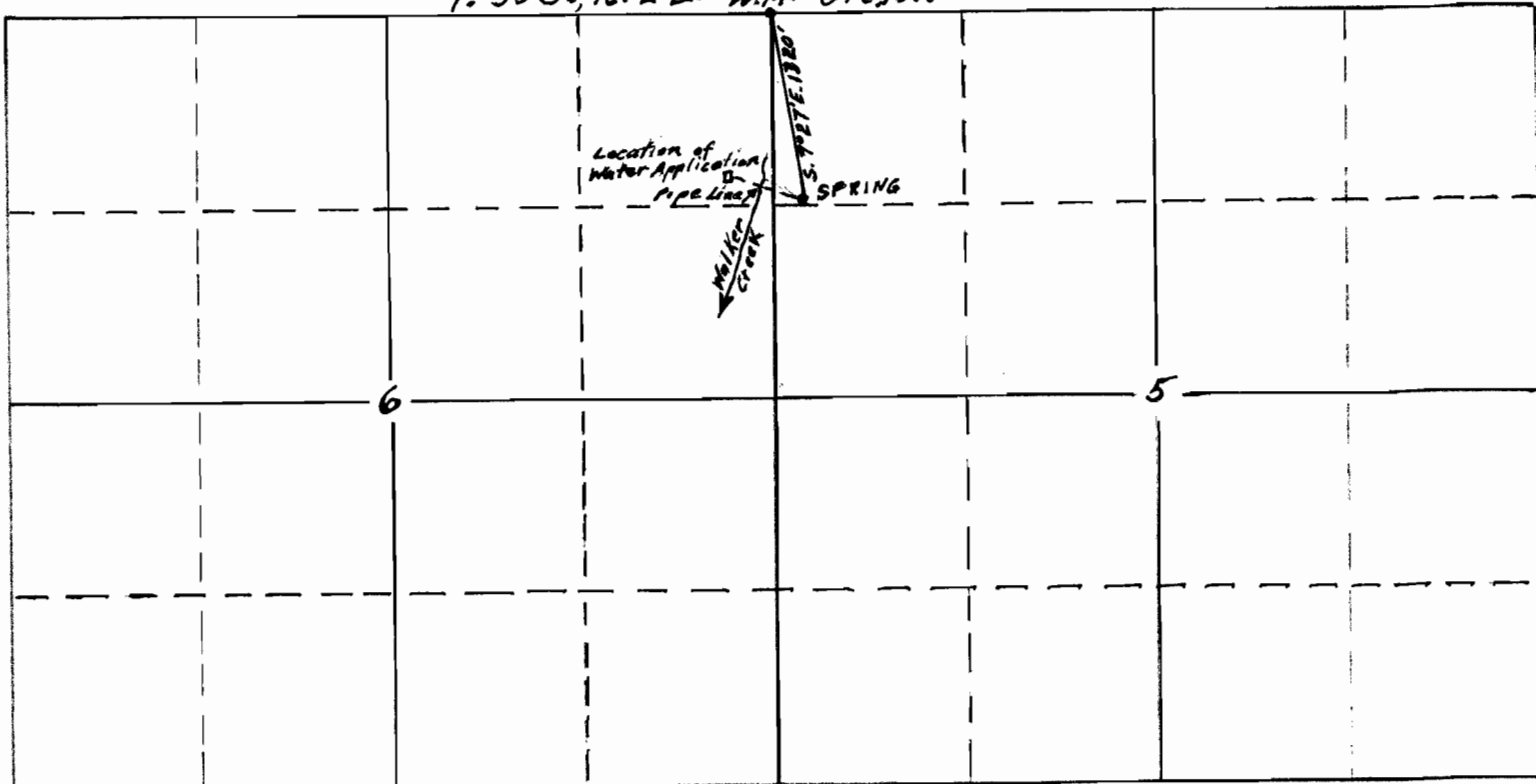

Application No. 33109
Permit No. 26172