


T.18S. R.47E.W.M.

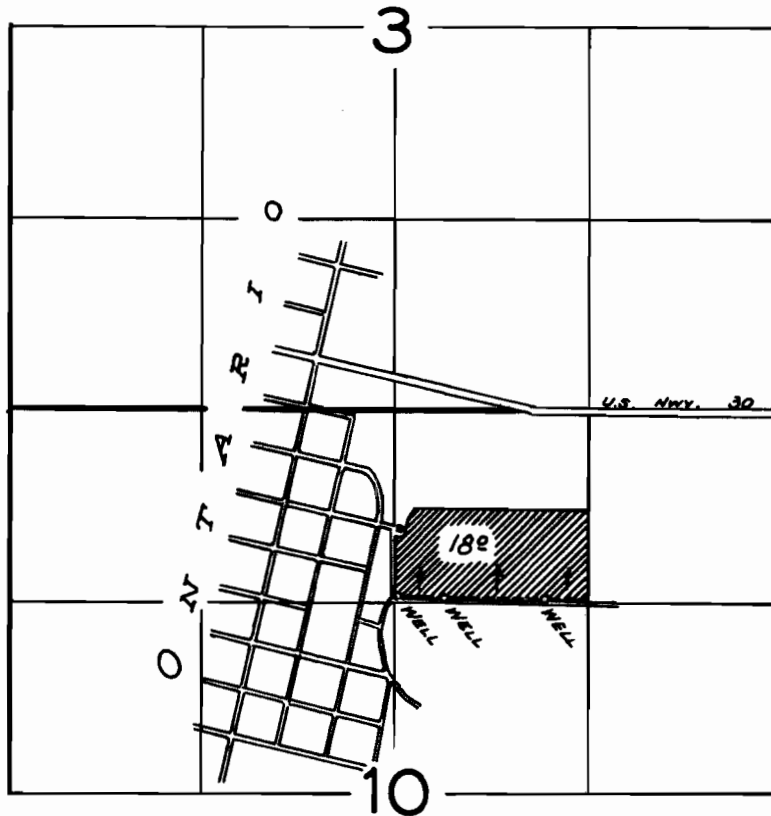

FINAL PROOF SURVEY

UNDER

Application No. G-96 Permit No. G-17

IN NAME OF

SUSAN HART

Surveyed Sept. 17, 1959, by RH Jackson