


T.4 S.R.I.W.W.M.

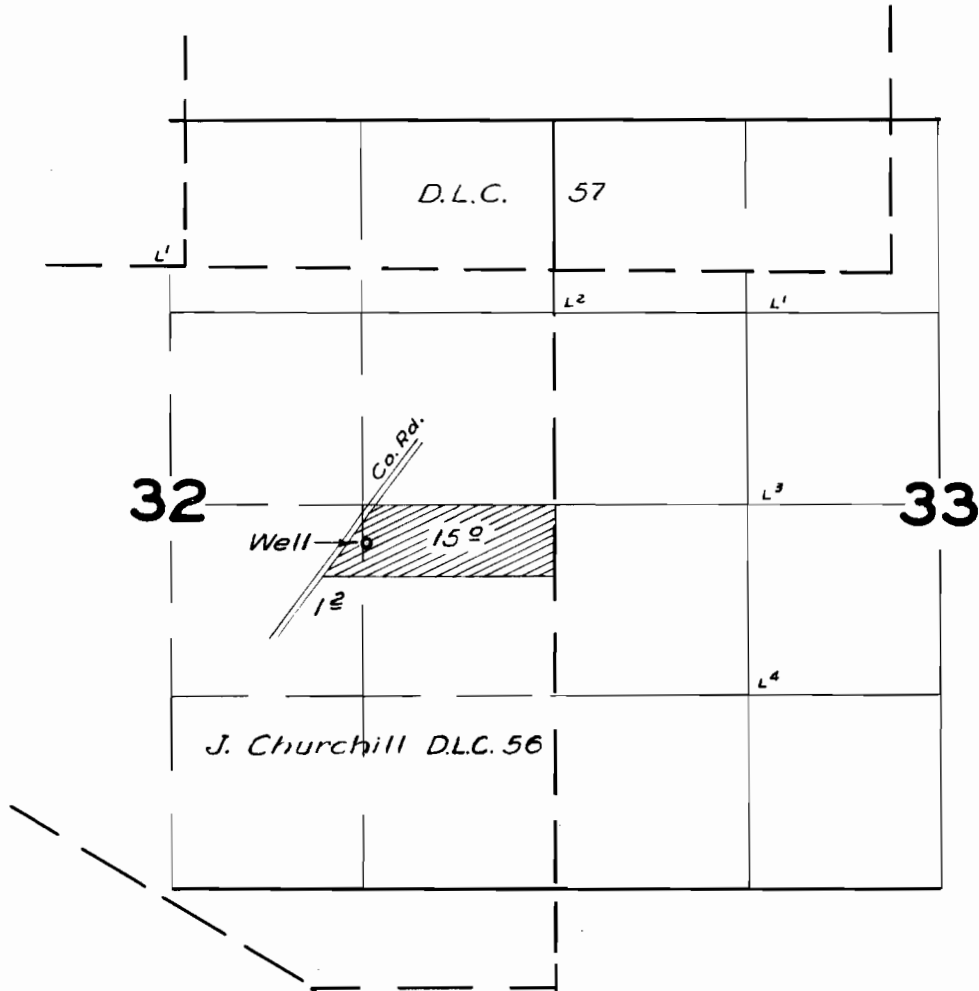

FINAL PROOF SURVEY UNDER

Application No. *G-140* Permit No. *G-41*
IN NAME OF

IVAN GHOSOPH

Surveyed *20 Mar. 1959*, by *Tm. Bish*