


T.17S. R.44E.W.M.

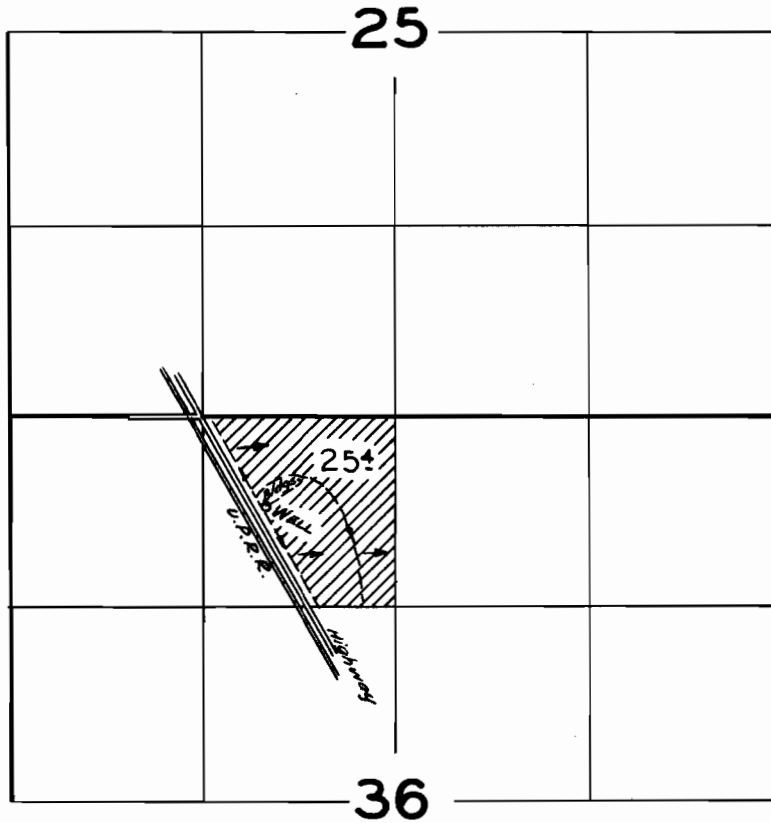

FINAL PROOF SURVEY
UNDER

Application No. G-112... Permit No. G-50...
IN NAME OF

J. P. ARCHULETA

Surveyed 25 Oct. 1958, by C.O. Bartels...