


T. 5S. R. 1W. W.M.

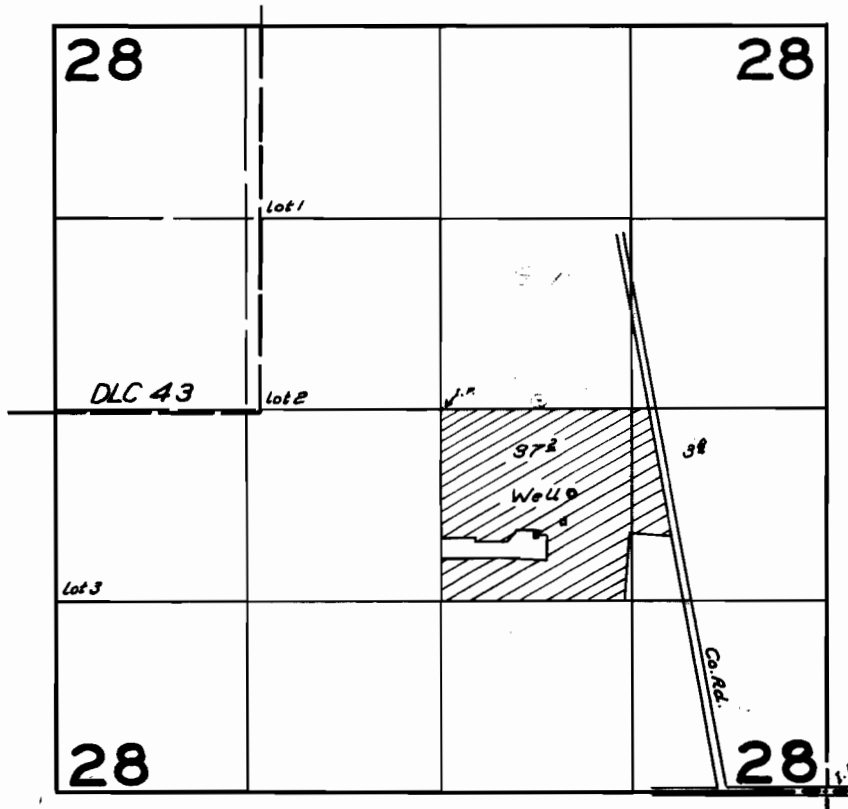

FINAL PROOF SURVEY
UNDER

Application No. *G.174* Permit No. *686*
IN NAME OF

Alfred Juve

Surveyed *April 24 19.59* by *R. H. Jackson*