


T. 11S. R. 4W. W.M.

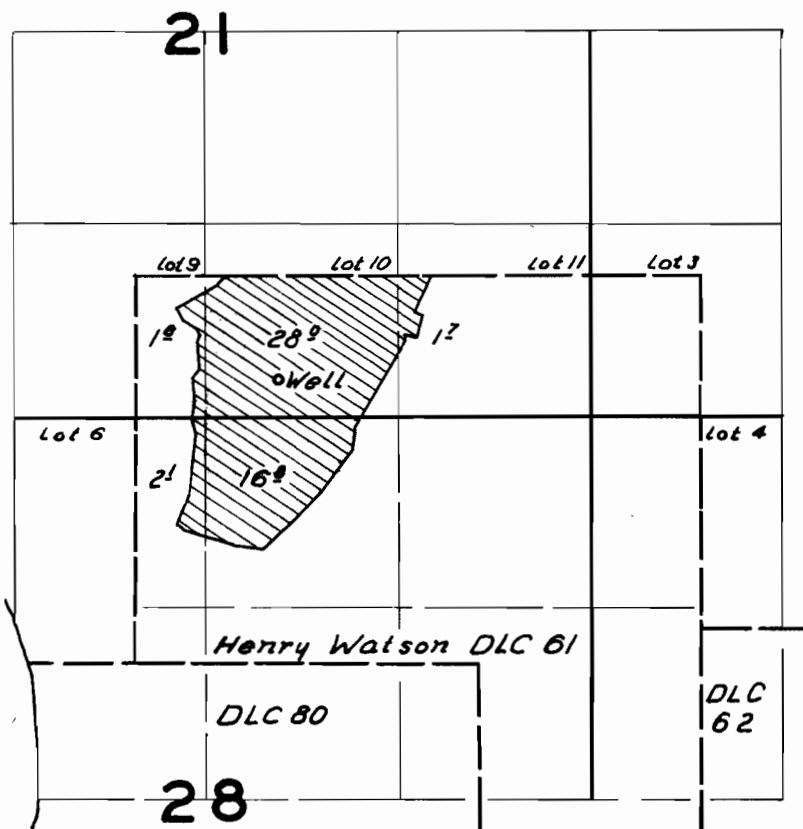

FINAL PROOF SURVEY

UNDER

Application No. G.238. Permit No. G146

IN FAVOR OF

Edwin S. & Lois G. Norris

Surveyed Aug. 24, 1959, by R.H. Jackson