


# T. 10S. R. 3&4W. W.M.

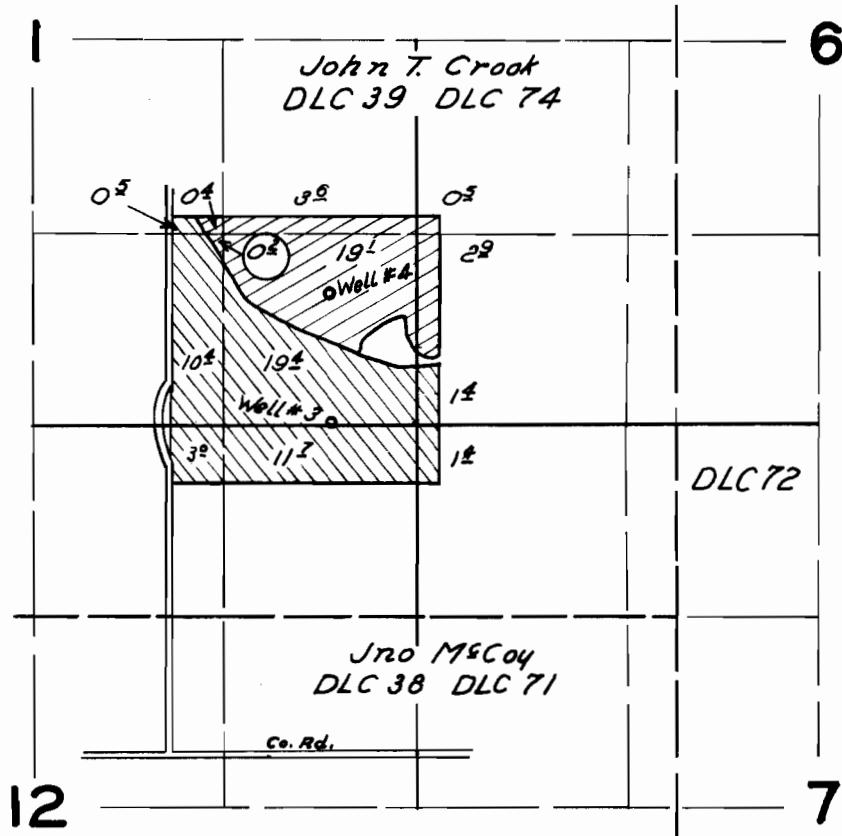

## FINAL PROOF SURVEY

UNDER

Application No. 6220 Permit No. 6234

IN NAME OF

Leo F. & Beryl G. Michele

Surveyed Aug. 24, 1959, by R.H. Jackson