


T. 5S. R. 1W. W.M.

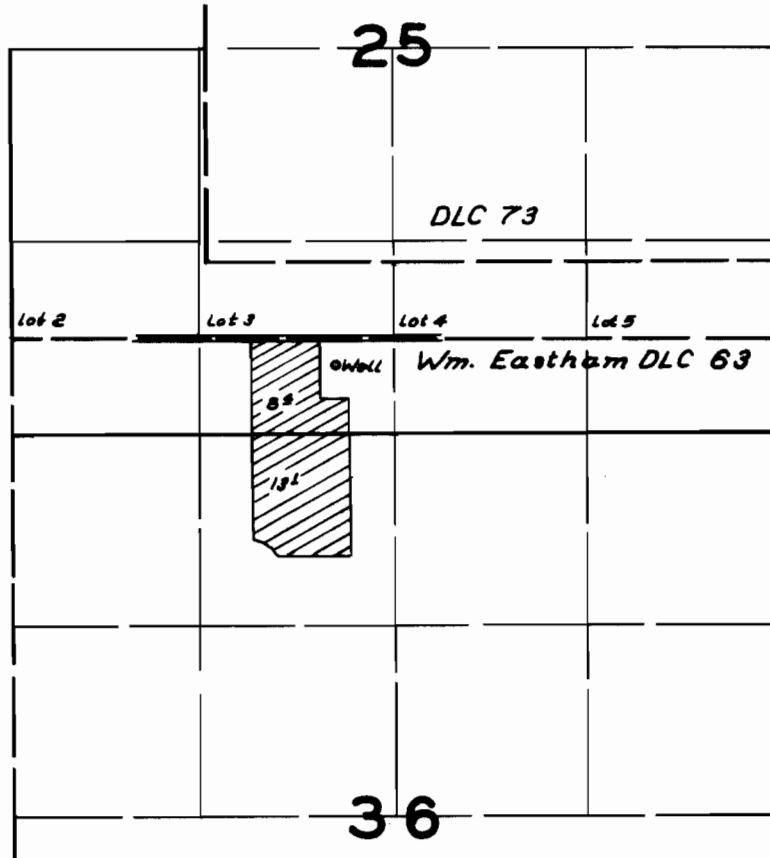

FINAL PROOF SURVEY
UNDER

Application No. *G436* Permit No. *G313*
IN NAME OF

George P. Fischer

Surveyed *May 21 1959*, by *R. H. Jackson*