


T.19S.R.43E.W.M.

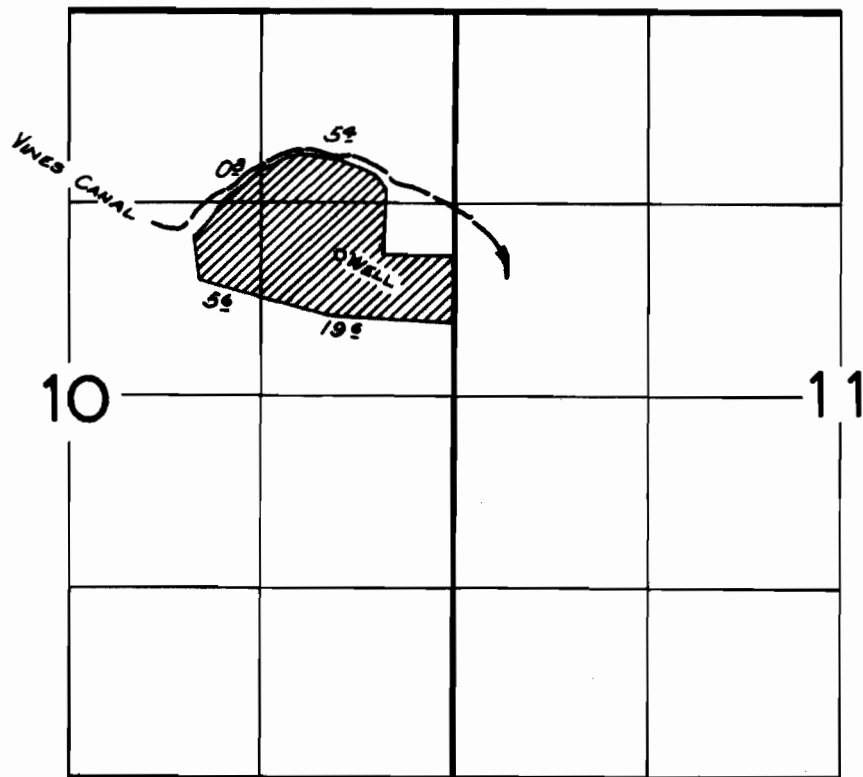

FINAL PROOF SURVEY

UNDER

Application No. G-459 Permit No. G-320

IN NAME OF

THOMAS J. DAVIS

Surveyed Sept. 26, 1959, by R. Jackson