


T.4 S.R.I.W.W.M.

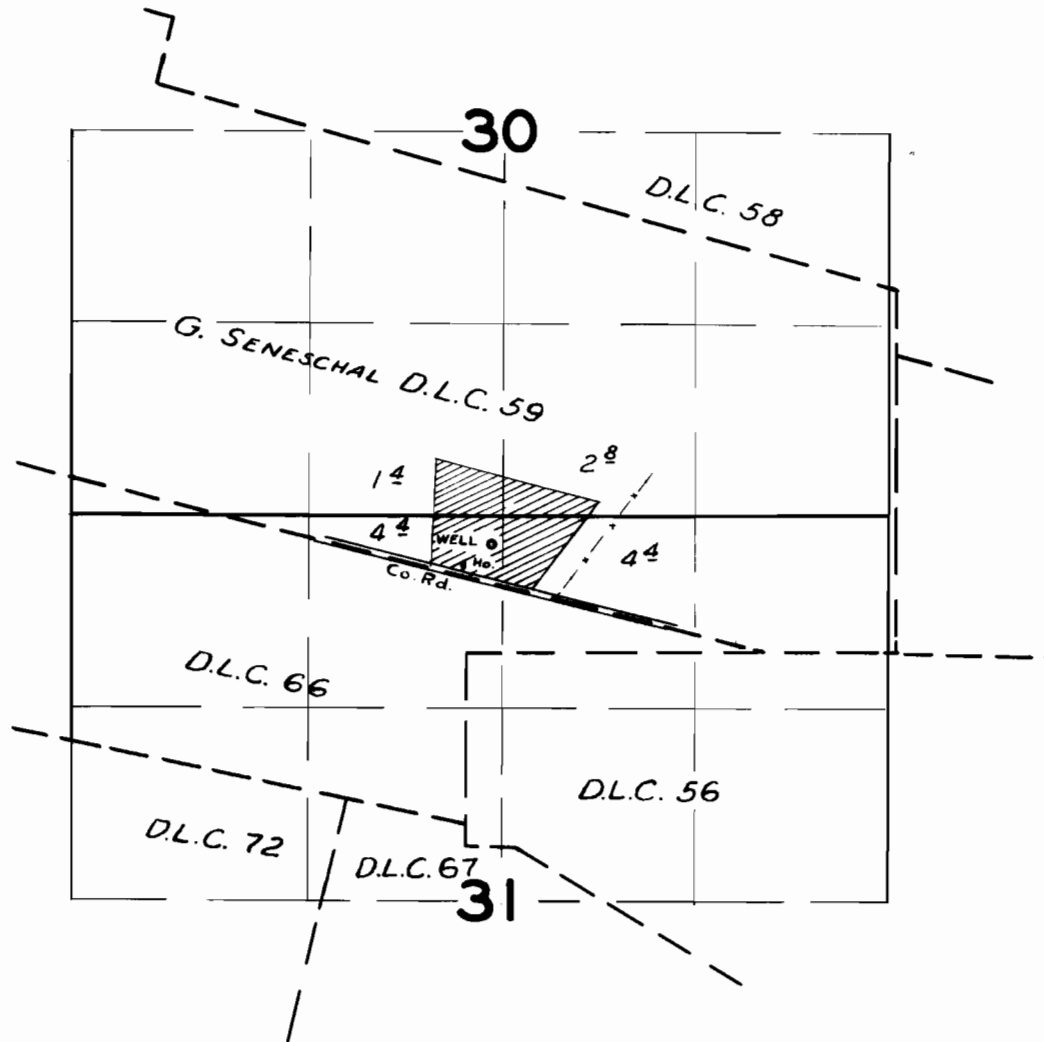

FINAL PROOF SURVEY UNDER

Application No. *G-443* Permit No. *G-331*
IN NAME OF

ISAAC HARVEY DE GROFF

Surveyed *20 Mar. 1959*, by *Tom B. Sibley*