


# T.28 S.R.15 E.W.M.

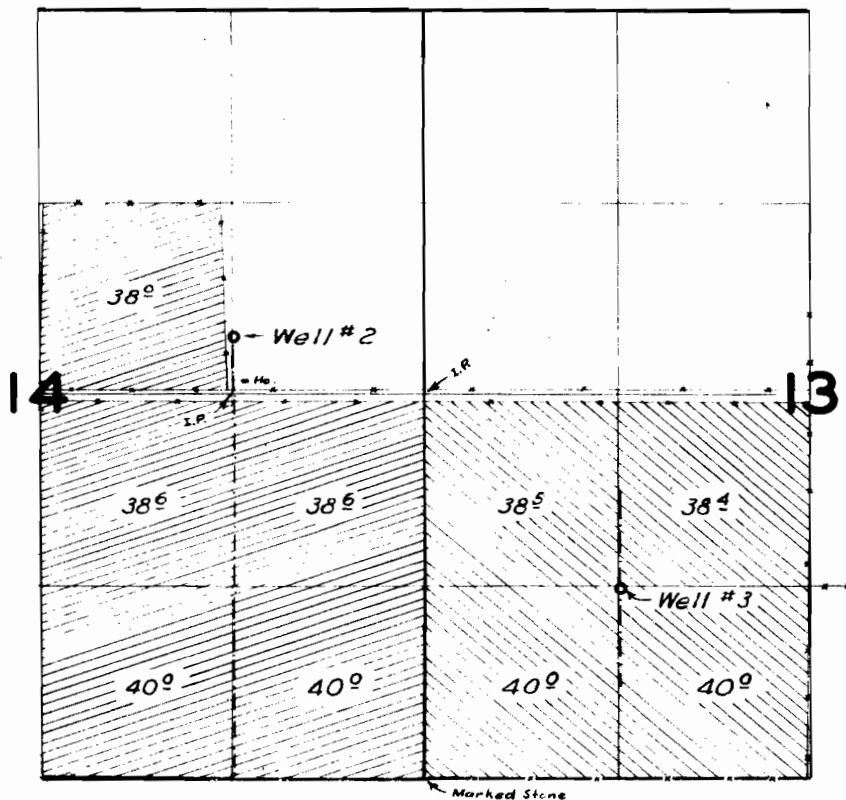

## FINAL PROOF SURVEY UNDER

Application No. *G-51* Permit No. *G-411*  
*G-50* *G-410*

IN NAME OF

*ALBERT E. ALBERTSEN*

Surveyed *5 May 1959*, by *M. Bish*