


T. 1 N. R. 12 E. W. M.

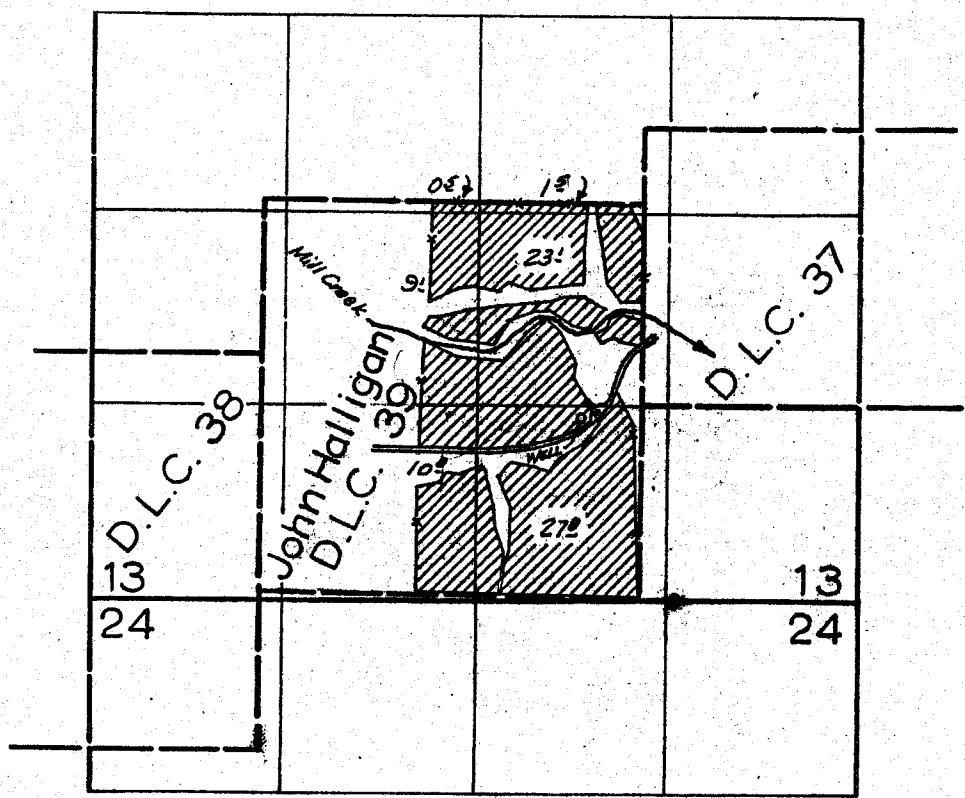

FINAL PROOF SURVEY

UNDER

Application No. G-170 Permit No. G-486

IN NAME OF

KENNETH W. KORTGE

Surveyed Nov. 16, 1959, by R. Jackson