


T. 18 S. R. 46 E. W.M.

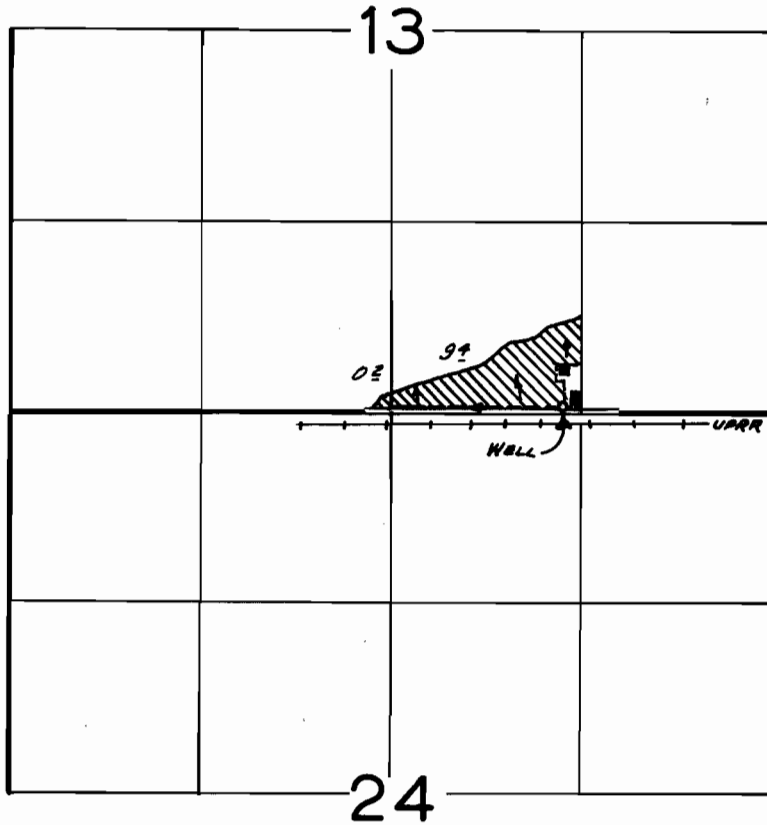

**FINAL PROOF SURVEY**  
UNDER

Application No. G-663 Permit No. G-664  
IN NAME OF

BRUCE B. HUNT

Surveyed Sept. 18, 1959, by R. Jackson