


G-854
26995

T.6N. R.35E.W.M.

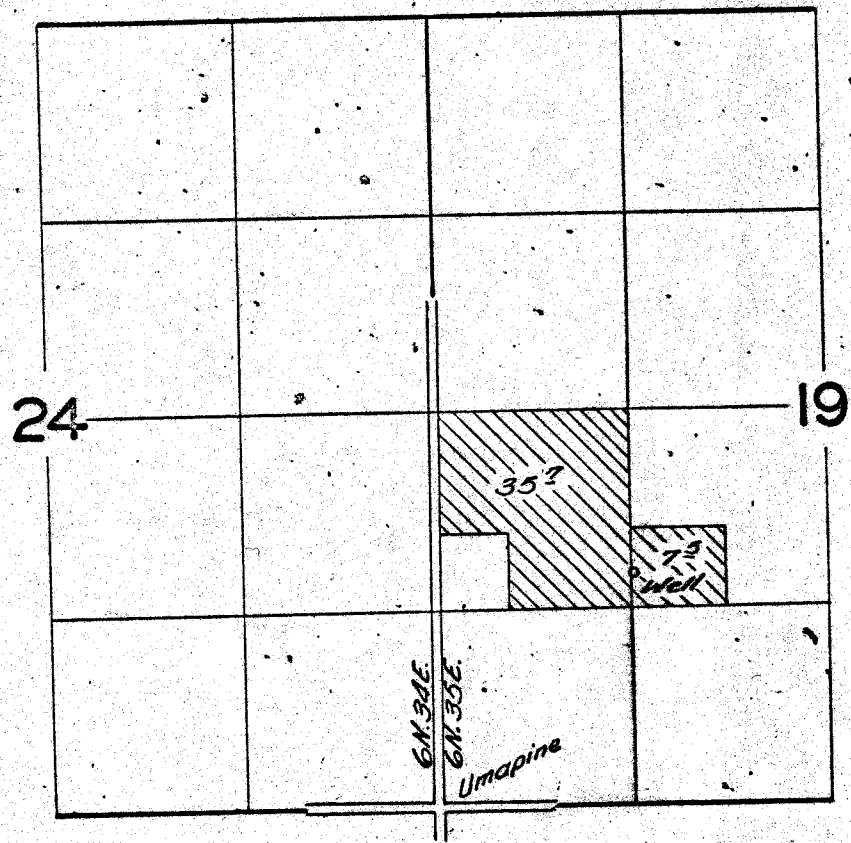

FINAL PROOF SURVEY

UNDER

Application No. G-941 Permit No. G-854

IN NAME OF

Pete & Errin Kessler

Surveyed Oct 22 19 59, by C. O. Smith