


T.18S. R. 47 E.W.M.

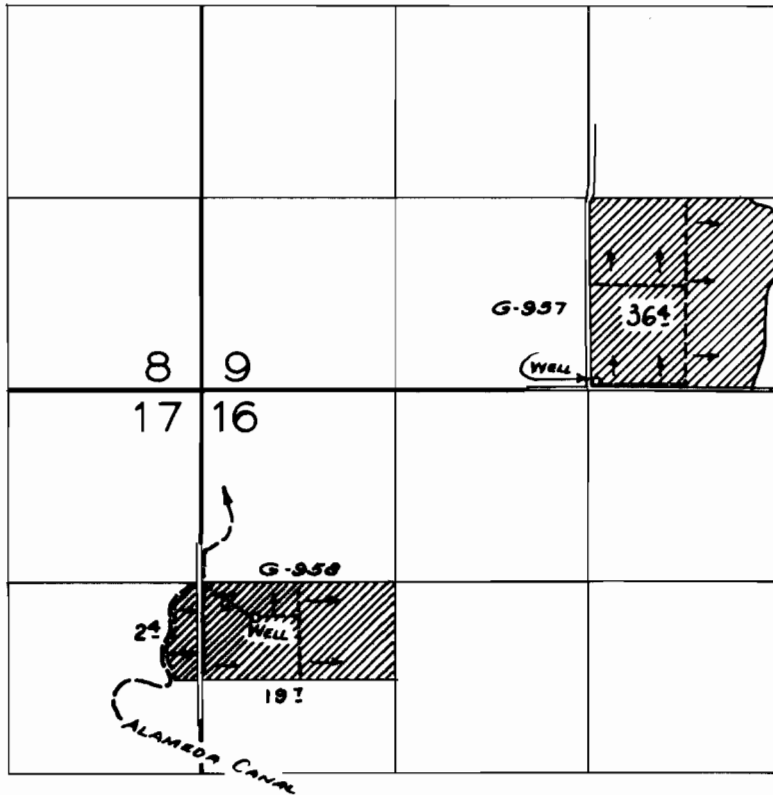

FINAL PROOF SURVEY
UNDER

Application No. ^{G-957} ~~G-958~~ Permit No. ^{G-859} ~~G-860~~
IN NAME OF

HARRY NAMBA

Surveyed Sept. 17, 1959, by *R. Jackson*