


T.18S. R.47 E.W.M.

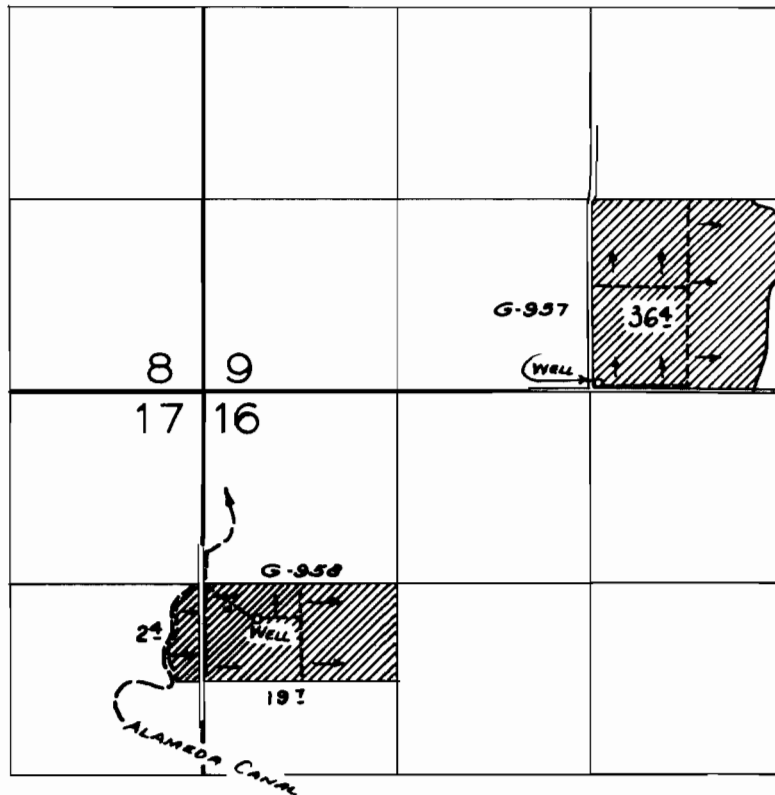

**FINAL PROOF SURVEY**  
UNDER

Application No. <sup>G-957</sup>~~G-958~~ Permit No. <sup>G-859</sup>~~G-860~~  
IN NAME OF

HARRY NAMBA

Surveyed Sept. 17, 1959, by R. H. Jackson