


T6N. R35E.W.M

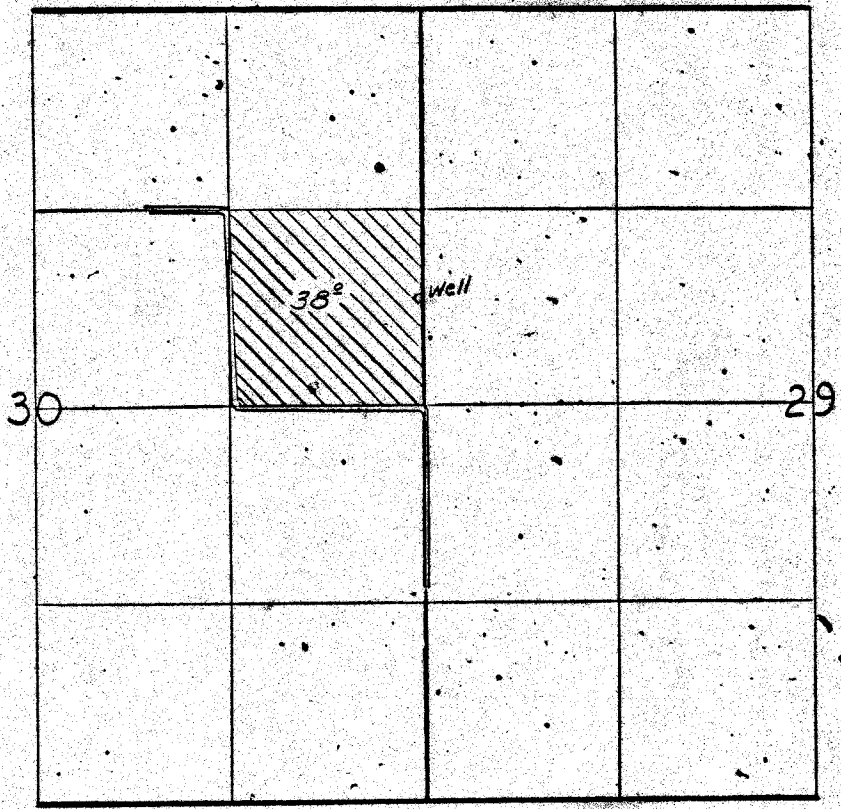

**FINAL PROOF SURVEY**

UNDER

Application No. G-1035 Permit No. G-906

IN NAME OF

Kenneth Derrick

Surveyed Oct. 22 1959. by C.O. Bird